


DX 78-1 Marion

Section 13 Township 21 Range 2E

Well No. #6 Frobenius

Company Anderson-Prichard

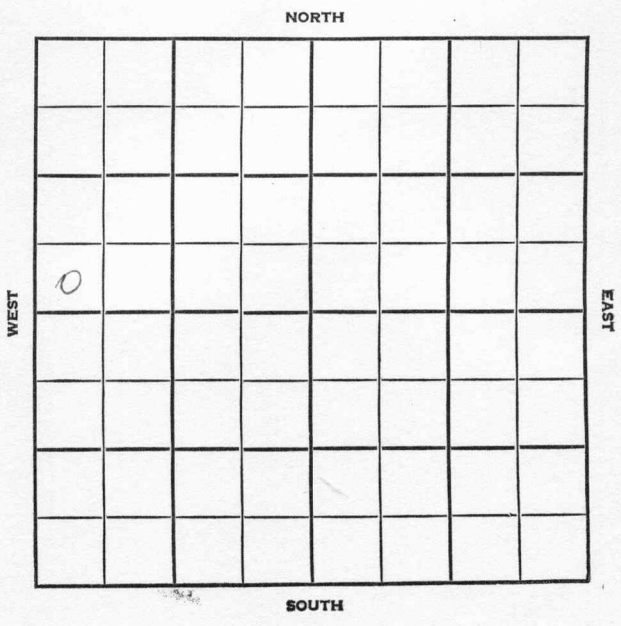

Marion

KANSAS

SEC. 13	TWP. 21	R. 2E
------------	------------	----------

WELL NO. #6 Frobenius FARM

COMPANY Anderson-Prichard

CONTRACTOR Peel

SW Unger


\_\_\_\_\_ FT. FROM N. LINE

\_\_\_\_\_ FT. FROM S. LINE

\_\_\_\_\_ FT. FROM E. LINE

\_\_\_\_\_ FT. FROM W. LINE

SW SW NW

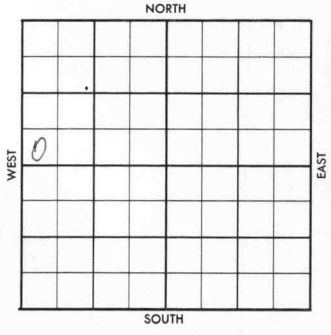

1956	ELEVATION	REPORT
------	-----------	--------

8-15 Comm. 8-11-56  
8" @ 124 w/155  
Drlg. 1870

**COMPLETED**

County Marion Elev. \_\_\_\_\_  
 Sec. 13 Twp. 21 Rge. 2E  
 Company Anderson-Prichard  
 Farm Name Frobenius No. 6

TOPS	DEPTH	LOG	DATUM
Anh.			
Tp.			
H.			
Tr.			
Dg.			
Bl.			
L.			
K.C.			
B.K.C.			
Ce.			
C.			
M.			
M.			
K.			
Mz.			
Ma.			
V.			
S.			
S.			
A.			
R.			
Pe.			
G.			
T.D.			

Loc. in Sec. \_\_\_\_\_  
SW SW NW  
 Geol. \_\_\_\_\_  
 Contr. \_\_\_\_\_  
Peel  
 Pool \_\_\_\_\_  
SW Unger

FIRST REPORT

0		

Date Comm. 8-11-56  
8" @ 124/155 drlg. 1870

2281 5 5 0UA

R.G.

Co.  
Lse.  
No.  
Sec.  
T.  
R.

Co.

County Marion Elev. 1500  
 Sec. 13 Twp. 21 Rge. 2E  
 Company Anderson-Prichard  
 Farm Name Frobenius No. 6

TOPS	DEPTH	LOG	DATUM
Anh.			
Tr.			
H.			
Tr.			
Dg.			
BL.			
L.			
K.C.			
B.K.C.			
Ce.			
C.			
M.	<u>2694</u>		
M.			
K.	<u>2776</u>		
Ma.	<u>Hunt 2912</u>		
Me.	<u>2933</u>		
V.			
S.			
S.			
A.			
R.			
PE.			
G.			
T.D.	<u>2945</u>		

Loc. in Sec. SW SW NW  
 Geol. \_\_\_\_\_  
 Contr. Peel  
 Pool SW Unger  

SEP 12 '56
0
COMPLETE

Loc.

No.

Date Comm. 8-11-56  
8" @ 12 1/2 / 155 drlg. 1870 AUG 22 '56  
5 1/2 @ 2944 1/2 / 130 WOC AUG 29 '56 CO  
2939 40 / 2914 - 24 FU 2000'  
oil now 2 1/4 hrs P.O.P. P.  
28 Bop in 2 hrs P. 13 Bophr  
1 hrs now SEP 5 '56 P. 155 Bophr  
+ Tr. w 2 hrs SEP 12 '56 Ph P  
137 Bophr now gran  
38.5

Sec.

T.

R.