


SECTION 13 TOWNSHIP 21 RANGE _____

WELL NO. #1 Frobenius "A"

COMPANY Anderson-Prichard Oil Corp.

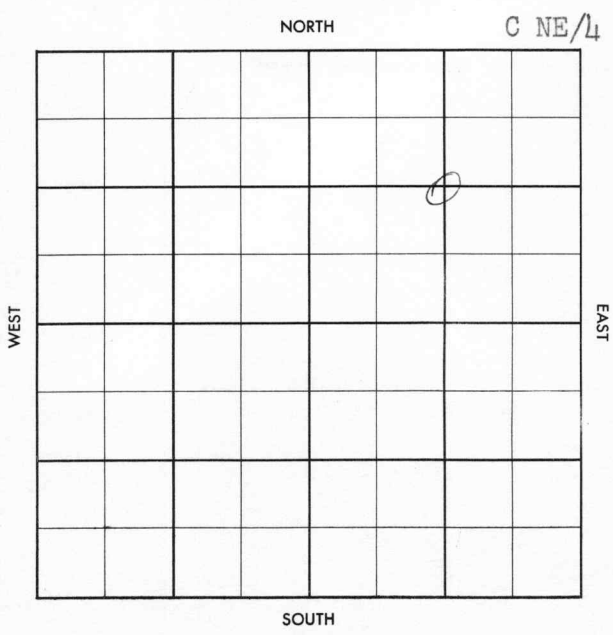

County Marion Elev. _____
 Sec. 13 Twp. 21 Rge. 2E
 Company Anderson-Prichard Oil Corp.
 Farm Name Frobenius "A" No. 1

TOPS	DEPTH	LOG	DATUM	Loc. in Sec.
Anh.				C NE/4
Tp.				
H.				
Tr.				
Dg.				
B.L.				
L.				Geol. _____
K.C.				Contr. _____
B.K.C.				
Ce.				
C.				
M.				Pool
M.				<u>Unger</u>
K.				
Mz.				
Mq.				
V.				
S.				
S.				
A				
R.				
Pf.				
G.				
T.D.				

JUN 12 57
 FIRST REPORT

Date Comm. _____
Cellar & Pits - to be S.W.D.W.

~~10~~

Co.
Lse.
No.
Sec.
T.
R.

County Marion Elev. 1443
 Sec. 13 Twp. 21 Rge. 2E
 Company Anderson-Prichard Oil Corp.
 Farm Name Fröbenius "A" No. 1

TOPS	DEPTH	LOG	DATUM
Anb.			
Tp.			
H.			
Tr.			
Dg.			
Bl.			
L.			
K.C.			
B.M.C.			
Ce.			
C.			
M.	2622		
M. <u>L1</u>	2647		
K.	2693		
Mz. <u>Hunt</u>	2843		
Me.	2845		
V.	2900		
S.	2961		
A.	3023		
R.			
Pe.			
G.			
T.D.	3360		

Loc. in Sec. C NE/4
 Geol. _____
 Contr. _____
 Pool Unser



Date Comm. _____
 Cellar & pits - to be S.W.D.W. JUN 19 57
 7-1-57 Lost circ @
 150 X 8" 219/225 Miss 2622
 M. L1 2647 Kd 2693 Hunt 2843
 3085 5 1/2 3074/100 CO
 3074 comp. SWD

~~SWD~~