


Map No. Kansas Sec. 13 Twp. 21 R. 4
 Well No. 4 Allison Farm
Sheedy & Empire Company

NORTH

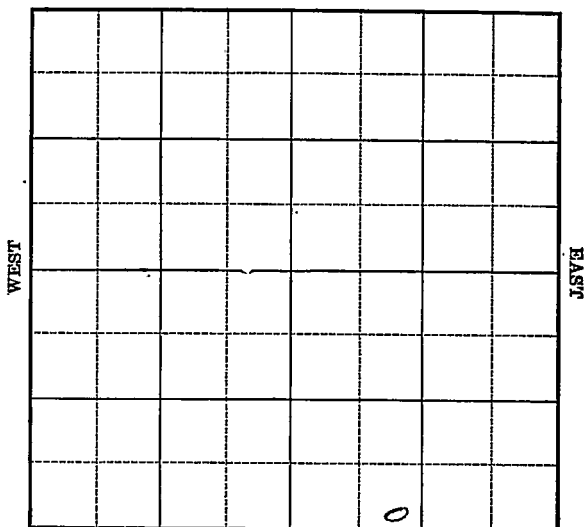

SOUTH

Location _____

Drilling Remarks

Rig Up _____

Drilling Remarks

RECORD

Cased _____ in. _____ ft.

Sand _____

Gas _____

Oil _____

Total Depth _____

PRODUCTION

1st 24 hrs. Nat. _____

1st 24 hrs. after shot _____

Gas _____ cu. ft.

Dry Hole _____


Abandoned _____

Map No. Kansas Sec. 13 Twp. 21 R. 4

Well No. 4 Allison Farm

Sheedy & Empire Company

NORTH

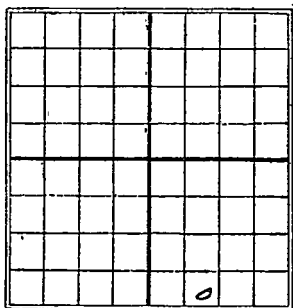

SOUTH

_____ Ft. from N. Line

200 Ft. from S. Line

_____ Ft. from E. Line

1120 Ft. from W. Line

Date
1925

REPORT

10/29 Location

11/6
11/19 Abandoned Loc

K23 *Marion Co*
 Map No. **KANSAS** Sec. *13* Twp. *21* R. *4*
 Well No. *4 Allison*
Sheddy & Empire Company
 Contractor

FIRST REPORTS

SECTION PLAT

Ft. from N. Line

200

Ft. from S. Line

Ft. from E. Line

1120

Ft. from W. Line

Location ✓

Rig up

Drilling and Remarks:

RECORD

Cased _____ in., _____ ft.

Sand _____

Gas _____

Oil _____

Total Depth _____

PRODUCTION

1st 24 hrs. Nat. _____

1st 24 hrs. after shot _____

Gas _____ Cu. Ft.

Dry Hole _____

Abandoned _____

Date

OCT 29 1925

192

CHAS. L. SHERWOOD

Scout

K23
 Map No. **KANSAS** Sec. *13* Twp. *21* R. *4*

Well No. *4* *Alkdon*

Shedy & Empire Company

Contractor

COMPLETED

_____ Ft. from N. Line

700 _____ Ft. from S. Line

_____ Ft. from E. Line

1120 _____ Ft. from W. Line

ABANDONED

SECTION PLAT

Location _____

Rig up _____

Drilling and Remarks:

Abandoned Location

RECORD

Cased _____ in., _____ ft.

Sand _____

Gas _____

Oil _____

Total Depth _____

PRODUCTION

1st 24 hrs. Nat. _____

1st 24 hrs. after shot _____

Gas _____ Cu. Ft.

Dry Hole _____

Abandoned *Location*

Date

NOV 19 1925

CHAS. L. SHERWOOD

_____ 192 _____ Scout