


KANSAS

Section 14 Township 21 Range 3-E

Well No. #1 Wenger

Company A D Allison etal
Wenger Pool

NORTH

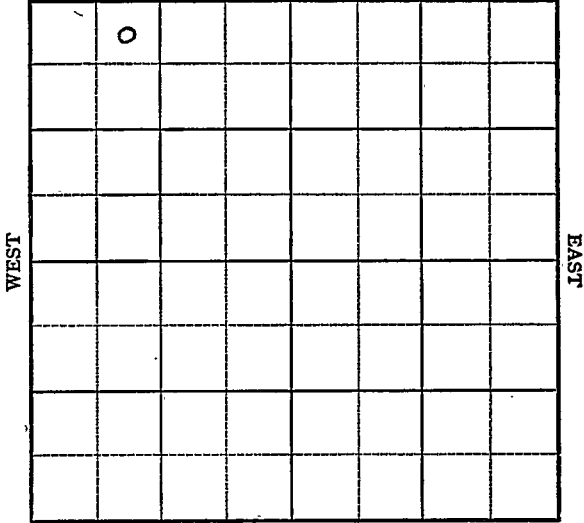

SOUTH

Sec. 14 Twp. 21 R. 3E

Well No. 1 Wenger Farm

A.D. Allison et al

Company
Contr. - Allison

Wenger Pool


330 Ft. from N. Line

_____ Ft. from S. Line

_____ Ft. from E. Line

990 Ft. from W. Line

NE NW NW

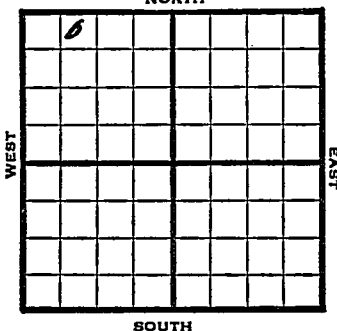

1949

Elev 1409'

REPORT

8/24 RUR

8/31 8" @ 66'

Dr lg. 1740'

9/7 "

9/14 TD 2790'

Missar 2780'

Mag 2781'

Aband.

ABANDONED

Map No. _____ Sec. 14 Twp. 21 R. 3E

Well No. 1 Wenger

A. D. Allison etal. Company

Allison Contractor

NE NW NW

FIRST REPORT
SECTION PLAT

330 Ft. from N. Line

_____ Ft. from S. Line

_____ Ft. from E. Line

990 Ft. from W. Line

Marion County

Location _____

Rig up _____

Drilling and Remarks:

R U R

RECORD

Cased _____ in., _____ ft.

Sand _____

Gas _____

Oil _____

Total Depth _____

PRODUCTION

1st 24 hrs. Nat. _____

1st 24 hrs. after shot _____

Gas _____ Cu. Ft.

Dry Hole _____

Abandoned _____

Date

AUG 21 1949 19

S. J. LEWIS

Scout

Map No. K24 Sec. 14 Twp. 21 R. 3E

Well No. 1 Wenger

A. D. Allison et al. Company

ABANDONED

Contractor

NE NW NW

E. 1409
SECTION PLAT

330 Ft. from N. Line

_____ Ft. from S. Line

_____ Ft. from E. Line

990 Ft. from W. Line

6			

Marion County

Location _____

Rig up _____

Drilling and Remarks:

Miscer 2780
Mag 2787.

RECORD

Cased _____ in., _____ ft.

Sand _____

Gas _____

Oil _____

Total Depth 2790

PRODUCTION

1st 24 hrs. Nat. _____

1st 24 hrs. after shot _____

Gas _____ Cu. Ft.

Dry Hole _____

Abandoned _____

Date

SEP 14 1949 19

S. J. LEWIS Scout