

Marion

KANSAS

Section 15 Township 21 Range 3E

Well No. #3 Ford

Company Roland Jones

NORTH

WEST

EAST

					0		

SOUTH

Marion **KANSAS** ✓
21 3E

15

Sec. _____ Twp. _____ R. _____

#3 Ford

Well No. _____ Farm _____

Roland Jones

Company _____

Slusser Drlg.

Contractor _____

Ft. from N. Line

990


Ft. from S. Line

Ft. from E. Line

990

Ft. from W. Line

NE SW NE

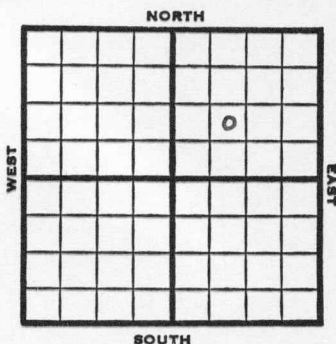

1953

Elev. 1416' REPORT

3/18

Location

5/6

Spud 3-21-53

SWD Well

Td 3038

8" @ 142

Cong 2499, Miss 2503, Kh. 2653, Chat
 2801, Misener 2806, VSSO, Maq 2808,
 Viola 2839, Simp dol. 2890

TD 2907


5" @ 2906

DD 2912, DD 3038

Comp. for SWD Well

ABANDONED

County Marion State Kansas
 Sec. 15 (Blk.) 21 (Sur.) 3E Map No.
 Operator Roland Jones
 Well No. 3 Farm Ford
 Elev. 1416 Location NE SW NE

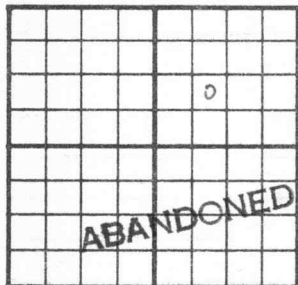

990 Ft. From S Line NE
990 Ft. From W Line Quarter

1st. Report

Completion MAY 6 1953

Remarks

Slusser Drlg. - Contr.

Spudding Date 3-21-53

Drlg. Data SWD well TD 3038

8" @ 142 Cong. 2499 Miss. 2503

Kh. 2653 Chat 2801 Misener 2806

VSSO Maq. 2808 Viola 2839

Simp. dol. 2890 TD 2907 5" @ 2906

DD 2912 DD 3038 Comp. for SWD well

J. G. McGEHEE