

Section 15 Township 21 Range 3 EWell No. # 1 Sol. LeppkeCompany Roland Jones

NORTH

						0	

WEST

EAST

SOUTH

Marion

KANSAS

SEC.	TWP.	R.
15	21	3E ✓

WELL NO.

1 Sol. Lappke

FARM

COMPANY

Roland Jones

CONTRACTOR

Slusser Drlg.

Wenger Pool

Ft. from N. Line

990


Ft. from S. Line

990

Ft. from E. Line

Ft. from W. Line

NW SE NE

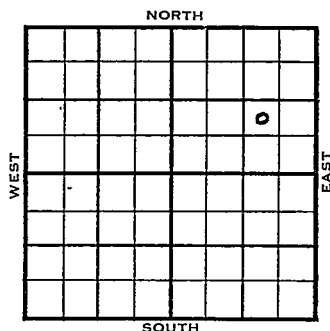

1953

ELEVATION

1409'

REPORT

10/21

Cellar & Pits

12/2

Spud 10-24-53

Oil Well

TD 2801'

8" @ 89'

Burgess 2488', Miss 2496', Kh.
 2642', Chat 2794', Meisner 2798',
 Hunton 2799'

TD 2801'

5" @ 2800'

CO to 2801'

FU 125' oil, 1000A

FU 1500' oil, 300' wtr, 12 hrs.

Comp. 25 bopd 5 bw

COMPLETED


J. G. McGEHEE

County Marion State Kansas
 Sec. 15 (Blk. 21 (Sur. 3E Map No.
 Twp.) Rge.)

Operator Roland Jones

Well No. 1 Farm Sol. Leppke

Elev. 1409 Location NW SE NE

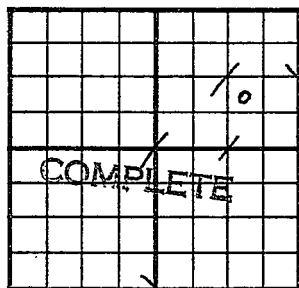

990 Ft. From S Line NE

990 Ft. From E Line Quarter

1st. Report

Completion DEC 2 1953

Remarks Wenger Pool

Slusser Drlg. - Contr.

Spudding Date 10-24-53

Drlg. Data Oil well TD 2801

8" @ 89 Burgess 2488 Miss. 2496

Kh. 2642 Chat. 2794 Meisner 2798

Hunton 2799 TD 2801 5" @ 2800

CO to 2801 FU 125' oil 1000 A

FU 1500' oil 300' wtr. 12 hr.

Comp. 25 bopd 5 bw

J. G. McGEHEE