


DX 78-1 Mabion

KANSAS

Section 15 Township 21 Range 3E

Well No. #4 Leppke

Company Roland Jones

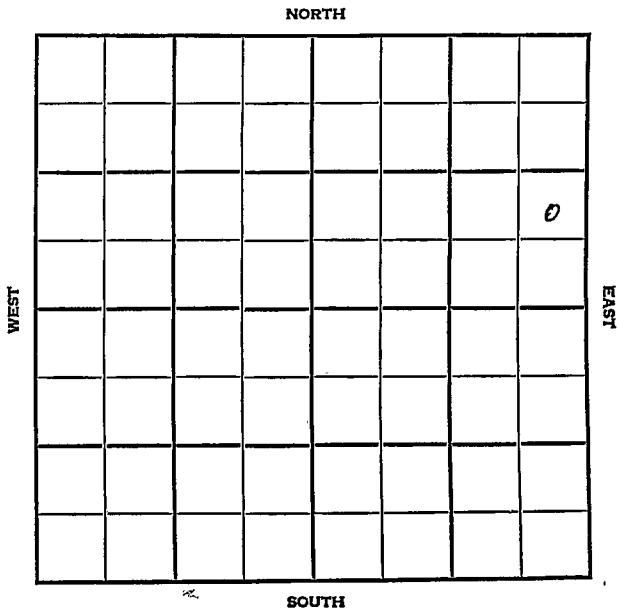

Marion

KANSAS

|      |      |    |
|------|------|----|
| SEC. | TWP. | R. |
| 15   | 21   | 3E |

WELL NO.

#4 Leppke

FARM

COMPANY

Roland Jones

CONTRACTOR

Slusser Drlg.

Wenger Pool

NORTH

|  |  |  |  |  |  |  |   |
|--|--|--|--|--|--|--|---|
|  |  |  |  |  |  |  |   |
|  |  |  |  |  |  |  |   |
|  |  |  |  |  |  |  | 0 |
|  |  |  |  |  |  |  |   |
|  |  |  |  |  |  |  |   |
WEST

EAST

SOUTH

Ft. from N. Line

965

Ft. from S. Line

400

Ft. from E. Line

Ft. from W. Line

NE SE NE

|       | ELEVATION                              | REPORT    |
|-------|----------------------------------------|-----------|
| 1954  | -                                      |           |
| 11/3  | Spud 10-29-54<br>8" @ 91'              |           |
|       | Drlg. 1700'                            |           |
| 11/10 | Spud 10-29-54<br>D & A<br>TD 2815'     |           |
|       | 8" @ 91'                               |           |
|       | Chattanooga sh. 2200', Misener 2804'-0 |           |
|       | 6', Maq 2806'                          |           |
|       | TD 2815'                               |           |
|       | D & A                                  |           |
|       |                                        | ABANDONED |

County Marion State Kansas

Sec. **15** (Blk. **21** (Sur. **3E** Map No.

Operator **Roland Jones**

Well No. 4 Farm Leppke

| Elev. | Location | NE | SE | NE |
|-------|----------|----|----|----|
|-------|----------|----|----|----|

0

FIRST REPORT

965 Ft. From S Line NE

400 Ft. From E Line Quarter

1st. Report NOV 3 1954

Completion \_\_\_\_\_

Remarks \_\_\_\_\_


Slusser Drig. - Contr.

Spudding Date 10-29-54

Drig. Data Wenger Pool

8<sup>th</sup> @ 91 drlg. 1700

FABEN GELSTRAP

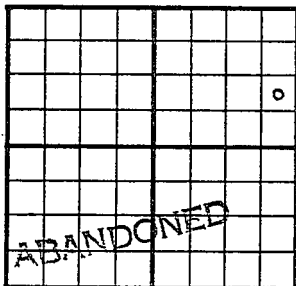County Marion State KansasSec. 15 (Blk.) 21 (Sur.) 3E Map No.Operator Roland JonesWell No. 4 Farm LeppkeElev. Location NE SE NE965 Ft. From S Line NE400 Ft. From E Line Quarter1st. Report NOV 1 6 1954

Completion

Remarks Wenger PoolSlusser Drlg. - Contr.Spudding Date 10-29-54Drlg. Data D & A TD 28158" @ 91 Chattanooga sh. 2200 Misener2804-06 Maq. 2806 TD 2815D & A

FABEN GILSTRAP