


FORM 51

Marion

Section 15 Township 21 Range 3E

Well No. 2 Hall

Company Roland Jones et al

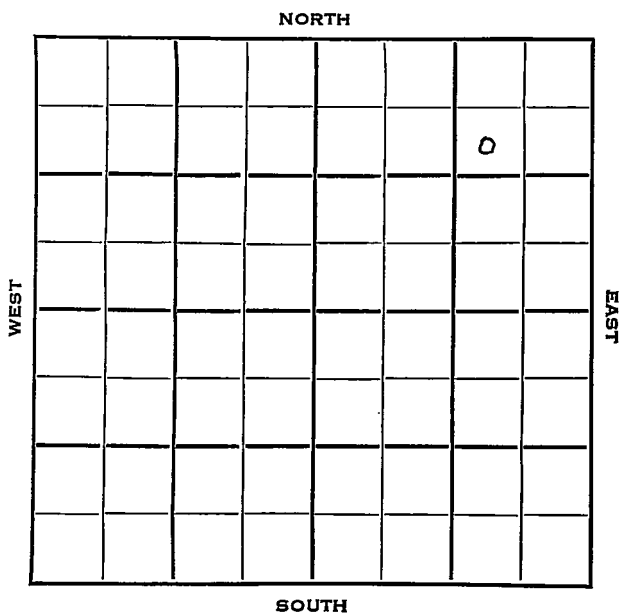

Marion

KANSAS ✓


Sec. 15 Twp. 21 R. 3EWell No. #2 Hall FarmRoland Jones et al CompanySlusser Drlg. ContractorWenger Pool990 Ft. from N. Line

Ft. from S. Line

990 Ft. from E. Line

Ft. from W. Line

SW NE NE

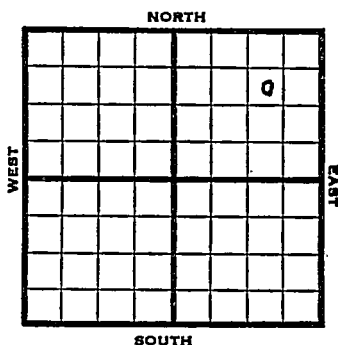

1953 Elev. 1404' REPORT

1/14 Spud 1-12-53  
Drlg.

2/25 Spud 1-12-53  
Oil Well  
TD 2797  
Miss 2496, Misener 2795, Hunton  
2796  
TD 2797  
5" @ 2796  
CO to 2797  
B/oil & wtr 500A  
Comp. 50 bopd 75 bw

COMPLETED

County Marion State Kansas

Sec. 15 (Blk. Twp.) 21 (Sur. Rge.) 3E Map No.

Operator      Roland Jones etal.

Well No. 2 Farm Hall

| Elev. | Location | SW | NE | NE |
|-------|----------|----|----|----|
|-------|----------|----|----|----|

[illegible]

990 Ft. From N Line NE

990 Ft. From F Line Quarter

1st. Report JAN 14 1953

## Completion

### Remarks

Slusser Drlg. - Contr.

Spudding Date **1-12-53**

Drlg. Data

## Wenger Pool

drig.

J. G. McGEHEE

County Marion State Kansas

Sec. 15 (Blk. Twp.) 21 (Sur. Rge.) 3E Map No.

Operator Roland Jones et al.

Well No. 2 Form Hall

Elev. 1404 Location SW NE NE

0

COMPLETE

990 Ft. From N Line NE

990 Ft. From E Line Quarter

### 1st. Report

Completion FEB 25 1953

Remarks      Wenger Pool

Slusser Drlg. - Contr.

Spudding Date 1-12-53

Drilg. Data      Oil well      TD 2797

Miss. 2496    Misener 2795    Hunton 2796

TD 2797 5" @ 2796 CO to 2797

B/ oil & wtr. 500 A Comp. 50 bopd 75 bw