


Marion

Section 15 Township 21 Range 3E

Well No. #3 Hall

Company Roland Jones

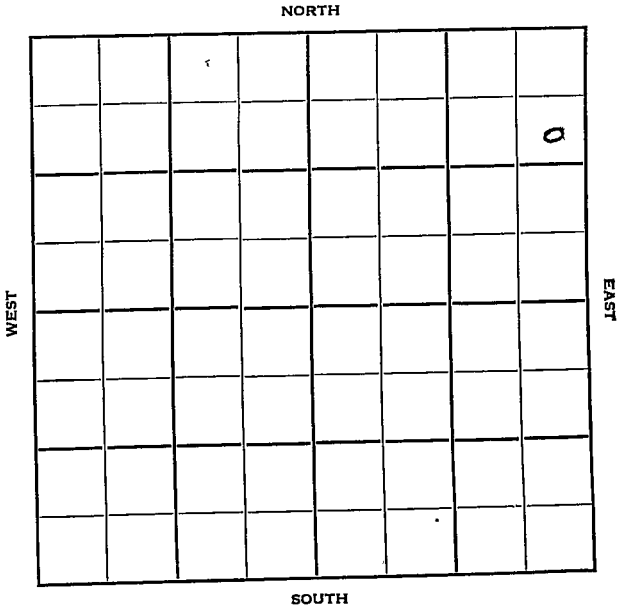

15

Sec. \_\_\_\_\_ Twp. \_\_\_\_\_ R. \_\_\_\_\_

#3 Hall

Well No. \_\_\_\_\_ Farm \_\_\_\_\_

Roland Jones

Company \_\_\_\_\_

Slusser Drlg.

Contractor \_\_\_\_\_

990

Ft. from N. Line


\_\_\_\_\_ Ft. from S. Line

330

Ft. from E. Line

\_\_\_\_\_ Ft. from W. Line

SE NE NE

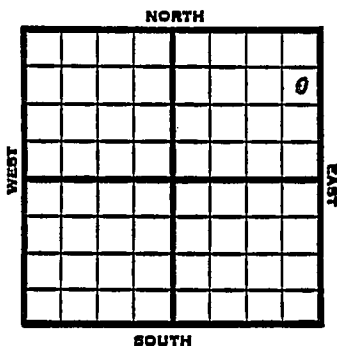

1953

Elev. 1405' REPORT

3/18

Location

7/1

Spud 5-24-53

Oil Well

TD 2801

8" @ 124

Burgess 2487, Miss 2493, Kh 2638,

Chat 2793, Misener 2797, Hunton 2799

TD 2801

5" @ 2798

CO to 2801

GU 250' oil 40' wtr., 1000A

FU 600' oil, 1500' wtr 12 hrs.

Comp. 20 bopd 60 bw



