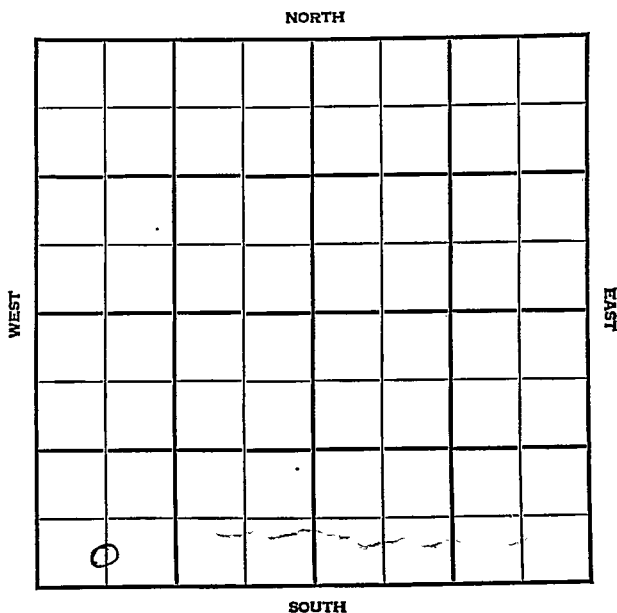


KANSAS Marion

Section 16 Township 21 Range 4EWell No. 1 RobinsonCompany C R A

Sec. 16 Twp. 21 R. 4E

Well No. #1 Robinson Farm

C. R. A. Company

Sellers


 Ft. from N. Line

330 Ft. from S. Line

 Ft. from E. Line

660 Ft. from W. Line

C S L SW SW

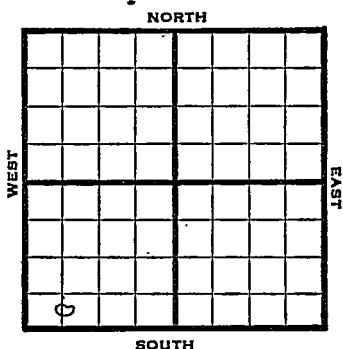

1948 Eli 1375' REPORT

4/28	All wells plugged. RUR
5/5	8" @ 118' Drlg. 1970'
5/12	KC 1763' Viola 2410' TD 2442' 5" @ 2431' RUST
5/19	Lansing 1763' Viola 2437' corrected
5/26	TD 2441' - 1900' oil 4 hrs.
6/1	Pump 8 bbls. oil / 100 W in 24 hrs.
6/9	PB 2439' Pump 10 bbls oil PH 3½ hrs.
6/16	Pump 15 bbls oil & W in 24 hrs.
6/23	" "
6/29	" "
7/8	" "
7/14	" "

OVER

1948

7/21

TD 2441'

Viola 2437'

5" @ 2431'

Pump 20' Oil / 100 W Pot

37° Gr.

Comp.

COMPLETED

Map No. _____ Sec. 16 Twp. 21 R. 4E

Well No. 1 Robinson

C R A Company

FIRST REPORT Contractor

C S L SW SW


SECTION PLAT

_____ Ft. from N. Line

330 Ft. from S. Line

_____ Ft. from E. Line

660 Ft. from W. Line

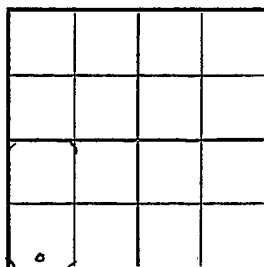

Marion County

Location _____

Rig up _____

Drilling and Remarks:

All wells plugged

R U R

RECORD

Cased _____ in., _____ ft.

Sand _____

Gas _____

Oil _____

Total Depth _____

PRODUCTION

1st 24 hrs. Nat. _____

1st 24 hrs. after shot _____

Gas _____ Cu. Ft.

Dry Hole _____

Abandoned _____

Date


APR 28 1948 19 _____ S. J. LEWIS Scout






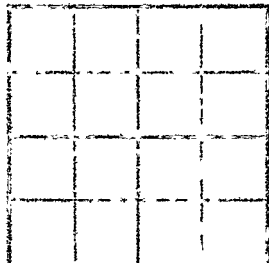








L. G. B.

125

70

and have

noted on


12/20/97 5:23 PM

Misc. Small Maps 2:43

Cards

Tracing

France Map

Scarborough Map


Pierce Map.

Geological Dept.

Pierce-Plat Book

Map No. 23 Sec. 16 Twp. 21 R. 4EWell No. 1 RobinsonC R A Company**COMPLETE**C S L SW SW ContractorE. B. B. B.

SECTION PLAT

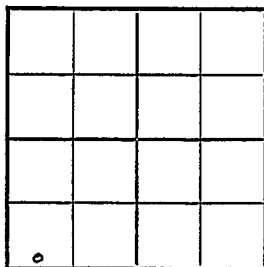 Ft. from N. Line330 Ft. from S. Line Ft. from E. Line660 Ft. from W. LineMarion County

RECORD

Location Cased in., ft.Rig up Sand

Drilling and Remarks:

Gas No. 2432Oil 5' @ 2431Total Depth 2441Pump 20 oil +
500 W. B. B.

PRODUCTION

1st 24 hrs. Nat. 1st 24 hrs. after shot Gas Cu. Ft.Dry Hole Abandoned

Date

JUL 21 194819S. J. LEWIS

Scout

*		



Revised

— in with
original bus can't be

Misc. Small Maps.

Cards

Tracing

France Map

Scarborough Map

Pierce Map

Geological Dept.

Pierce Plat Book

