
Marion

Form 51—5M—9-28—27423

Map No. KANSAS Sec. 16 Twp. 21 S R. 4E

Well No. 1-P Wagners Farm

Long Green Company

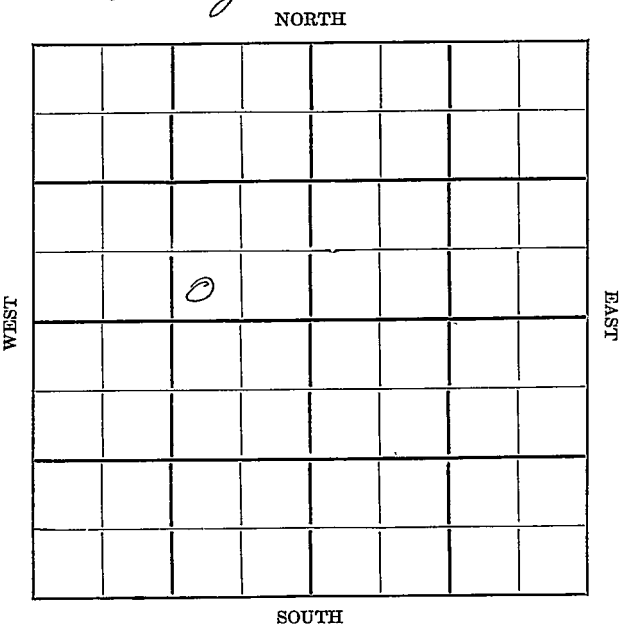

Location

Drilling Remarks

Rig Up

Drilling Remarks

RECORD

Cased ..... in. ..... ft.

Sand

Gas

Oil

Total Depth

PRODUCTION

1st 24 hrs. Nat.

1st 24 hrs. after shot

Gas ..... cu. ft.

Dry Hole


Abandoned

Form 252A—5M—5-28—Mid-West

Map No.....Sec.....Twp.....R.....

Well No.....Farm

.....Company

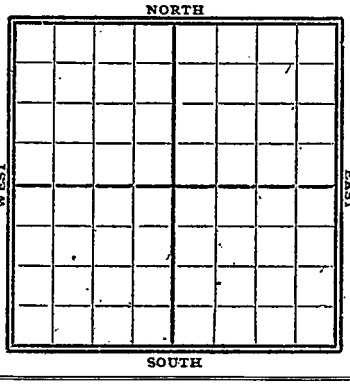

.....Ft. from N. Line

.....Ft. from S. Line

.....Ft. from E. Line

.....Ft. from W. Line

1922

Date	REPORT
	Gypsy Records
8/3	Abd Location

FORM 26 250 BKS. 4-28 WESTERN

Marion

K23 MAP NO. KANSAS SEC. 16 TWP. 21S R. 4E


WELL NO. 1 W. Ames

Long Green COMPANY

CONTRACTOR

SECTION PLAT

ABANDONED

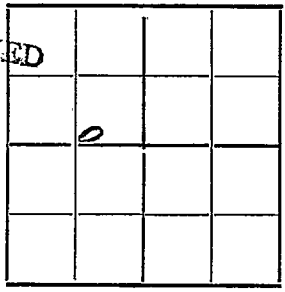

____ FT. FROM N. LINE

____ FT. FROM S. LINE

____ FT. FROM E. LINE

____ FT. FROM W. LINE

LOCATION

RIG UP ✓

DRILLING AND REMARKS:

abd location

RECORD

CASED ____ IN., ____ FT.

SAND

GAS

OIL

TOTAL DEPTH

PRODUCTION

1ST 24 HRS. NAT.

1ST 24 HRS. AFTER SHOT

GAS ____ CU. FT.

DRY HOLE

ABANDONED ✓

DATE 8/3/27 SCOUT