

Marion


KANSAS

SECTION 17 - TOWNSHIP 21 RANGE 3E

WELL NO. #5 Loewen

COMPANY Cities Service

NORTH

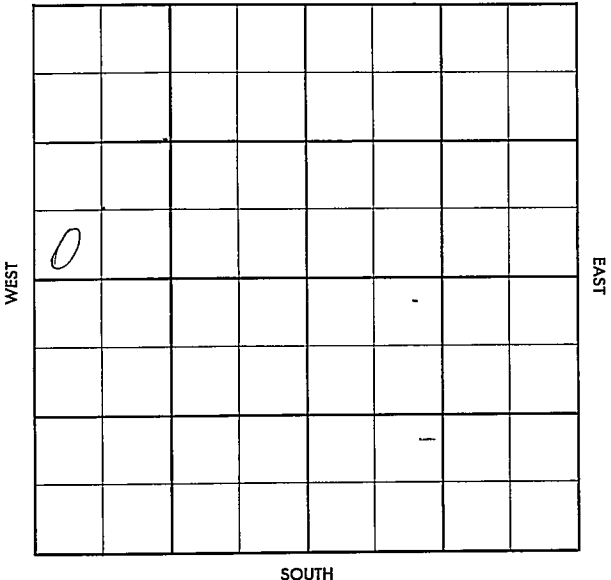

Marion

KANSAS

SEC.	TWP.	R.
17	21	3E

WELL NO.

#5 Loewer,

FARM

COMPANY

Cities Service

CONTRACTOR

White & Ellis


Unger

_____ Ft. from N. Line

_____ Ft. from S. Line

_____ Ft. from E. Line

_____ Ft. from W. Line

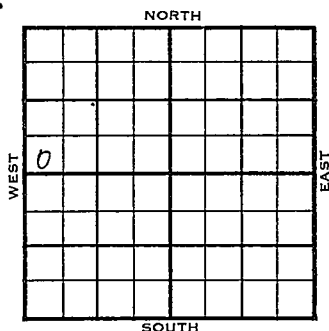

SW SW NW

	ELEVATION	REPORT
1956	1435'	

5-2 Comm. 5-1-56

5-16 8 5/8" @ 109 w/160

D&A

TD 2946'

Dg. Sd. 1799', L. 2011', KC. 2140',

BKC 2391', M. 2588', V. 2880',

S. Sd. 2944'.

ABANDONED

County Marion Elev. _____
 Sec. 17 Twp. 21 Rge. 3E
 Company Cities Service
 Farm Name Loewer No. 5

TOPS	DEPTH	LOG	DATUM	Loc. in Sec.
Anh.				SW SW NW
Tr.				
H.				
Tr.				
Dg.				
Bl.				
L.				Geol.
K.C.				Contr.
B.K.C.				White & Ellis
Ce.				
C.				Pool
M.				Unger
M.				
K.				
Mz.				
Mo.				
V.				
S.				
S.				
A.				
R.				
Pe.				
G.				
T.D.				

Date Comm. 5-1-56

8221 MAY 3 1956

W. G.

Co.

T. No.

Sec.

T.

R.

FORM 513 SUNRAY

County Marion Elev. 14.35
 Sec. 17 Twp. 21 Rge. 3E
 Company Cities Service
 Farm Name Loewer No. 5

TOPS	DEPTH	LOG	DATUM	Loc. in Sec.
Anh.				SW SW NW
Ip.				
H.				
Tr.				
Dg. <u>sd</u>	<u>1799</u>			
Bl.				
L.	<u>2011</u>			Geol.
K.C.	<u>2140</u>			Contr.
B.K.C.	<u>2391</u>			White & Ellis
Ce.				Pool
C.				Unger
M.	<u>2588</u>			
M. <u>no Hunt</u>				
K.				
Mz.				
Mo.				
V.	<u>2880</u>			
S. <u>sd</u>	<u>2944</u>			
S.				
A.				
R.				
Pe.				
G.				ABANDONED
T.D.	<u>2946</u>			MAY 16 1956

Date Comm. 5-1-56 MAY 9 '56 858 109/160

2140 MAY 15 '56

Dea