


Map No. _____ Sec. 17 Twp. 21 R. 4
 Well No. 15 - Reganley Farm _____
National Refg. Company _____

NORTH

WEST

EAST

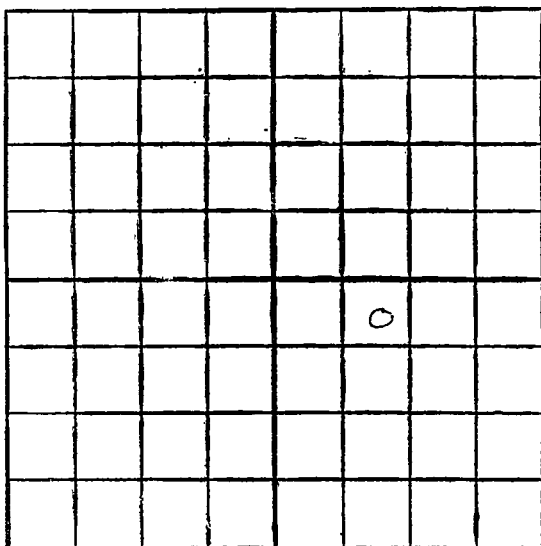

SOUTH

Location _____
 Drilling Remarks _____

Rig Up _____
 Drilling Remarks _____

RECORD

Cased _____ in. _____ ft.
 Sand _____
 Gas _____
 Oil _____
 Total Depth _____

PRODUCTION


1st 24 hrs. Nat. _____
 1st 24 hrs. after shot _____
 Gas _____ cu. ft.
 Dry Hole _____
 Abandoned _____

marion

Map No. 15 Sec. 17 Twp. 21 R. 4Well No. 15 Reaney Farm
National Refg. Company330 Ft. from N. Line

_____ Ft. from S. Line

_____ Ft. from E. Line

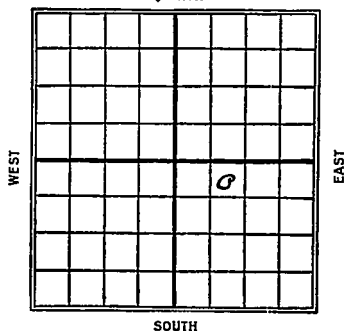990 Ft. from W. Line1926

Date

REPORT

11/17 Drilg 131011/23 " 152012/8 " 235012/15 Land 2416-2420200 bbls I.D. 2420

23 KANSAS Marion
 Map No. _____ Sec. 17 Twp. 21 R. 4
 Well No. 15 Blomen
 National Leasing Co. Company
 _____ Contractor

FIRST REPORTS

330 Ft. from N. Line
 _____ Ft. from S. Line
 _____ Ft. from E. Line
 990 Ft. from W. Line

SECTION PLAT

		0	

Location _____
 Rig up _____
 Drilling and Remarks:

Only 1310

RECORD

Cased _____ in., _____ ft.
 Sand _____
 Gas _____
 Oil _____
 Total Depth _____

PRODUCTION

1st 24 hrs. Nat. _____
 1st 24 hrs. after shot _____
 Gas _____ Cu. Ft.
 Dry Hole _____
 Abandoned _____

Date

NOV 17 1926

CHAS. L. SHERWOOD

192

Scout

23 KANSAS

Map No. _____ Sec. 17 Twp. 21 R. 4

Well No. 15

National Refg Co Company

Contractor

COMPLETED

SECTION PLAT

330 Ft. from N. Line

Ft. from S. Line

Ft. from E. Line

990 Ft. from W. Line

		0	

Location _____

Rig up _____

Drilling and Remarks:

200 Bl.

RECORD

Cased _____ in., _____ ft.

Sand 2416-2420

Gas _____

Oil _____

Total Depth 2420

PRODUCTION

1st 24 hrs. Nat. _____

1st 24 hrs. after shot _____

Gas _____ Cu. Ft.

Dry Hole _____

Abandoned _____

Date

DEC 15 1926

CHAS. L. SHERWOOD

192

Scout