

[illegible]

Abandoned_____

Map No. KANSAS Sec. 17 Twp. 21 R. 4^E
Well No. 17- Perry Farm
National Refg Company
NORTH


Ft. from N. Line

330 Ft. from S. Line

1320 Ft. from E. Line

Ft. from W. Line

1430

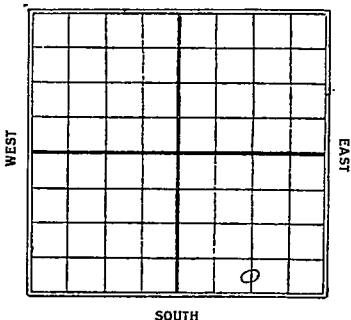

Date _____

REPORT

6/25 P.O.S.
7/2 Rign up
7/9 Spdy
7/16 Rrlg 1000'
7/23 " 1840'
7/30 ~~8"~~ 8" 2215'
8/6 Sand 2408-09 1/2
TO 2409 1/2
180 bbl oil
Comp.

Marion

Map No. **KANSAS** Sec. 17 Twp. 21 R. 4
 Well No. 17 Romey
National Ref Co Company
 Contractor

COMPLETE

_____ Ft. from N. Line
330 Ft. from S. Line
1320 Ft. from E. Line
 _____ Ft. from W. Line

SECTION PLAT

			0

Location _____

Rig up _____

Drilling and Remarks:

180 Bls.

RECORD

Cased _____ in., _____ ft.
 Sand 2408-09 ✓
 Gas _____
 Oil _____
 Total Depth 2409 ✓

PRODUCTION

1st 24 hrs. Nat. _____
 1st 24 hrs. after shot _____
 Gas _____ Cu. Ft.
 Dry Hole _____
 Abandoned _____

Date

AUG 6 1930

CHAS. L. SHERWOOD

19

Scout

Marion

E

KANSAS

Map No. _____ Sec. 17 Twp. 21 R. 4Well No. 23 17 Rene,National Rey Co Company

Contractor

FIRST REPORTS

SECTION PLAT

			0

_____ Ft. from N. Line

330 Ft. from S. Line1320 Ft. from E. Line

_____ Ft. from W. Line

Location Boley

Rig up _____

Drilling and Remarks:

RECORD

Cased _____ in., _____ ft.

Sand _____

Gas _____

Oil _____

Total Depth _____

PRODUCTION

1st 24 hrs. Nat. _____

1st 24 hrs. after shot _____

Gas _____ Cu. Ft.

Dry Hole _____

Abandoned _____

Date

JUN 25 1930

19

CHAS. L. SHERWOOD

Scout