


Section 17 Township 21 Range 4E

Well No. #23 Reamey

Company C R A

**Sellers Pool**

NORTH

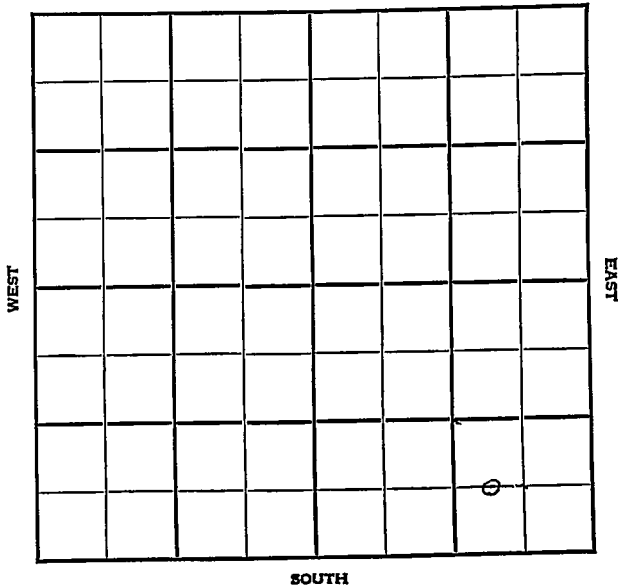

Sec. 17 Twp. 21 R. 4E

Well No. #23 Reamey Farm

C. R. A. Company


Sellers

         Ft. from N. Line

330 Ft. from S. Line

         Ft. from E. Line

660 Ft. from W. Line

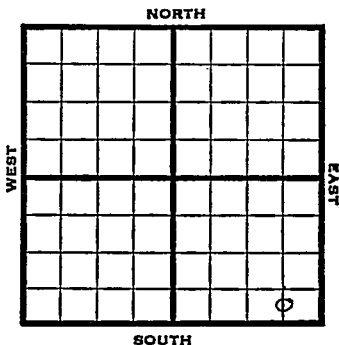

C S L SE SE

1948 Elev. 1386' REPORT

4/14 RUR

4/21 8" @ 115'  
Drlg. 1580'

4/28 Lansing 1763'  
KC 1998'  
Drlg. 1998'

5/5 Kinderhook 2283'  
Viola 2391'  
TD 2401'  
5" @ 2391'  
2 B oil PH

5/12 Viola 2391'  
5" @ 2391'  
1000 acid  
Pump 15 oil Pot  
36.0 Gr.  
TD 2401'  
Comp.

**COMPLETED**

Map No. \_\_\_\_\_ Sec. 17 Twp. 21 R. 4E

Well No. 23 Reamey

C R A \_\_\_\_\_ Company

FIRST REPORT \_\_\_\_\_ Contractor

C S L SE SE

SECTION PLAT

\_\_\_\_\_ Ft. from N. Line

330 Ft. from S. Line

\_\_\_\_\_ Ft. from E. Line

660 Ft. from W. Line

			o

Marion County

Location \_\_\_\_\_

Rig up \_\_\_\_\_

Drilling and Remarks:

R U R

RECORD

Cased \_\_\_\_\_ in., \_\_\_\_\_ ft.

Sand \_\_\_\_\_

Gas \_\_\_\_\_

Oil \_\_\_\_\_

Total Depth \_\_\_\_\_

PRODUCTION

1st 24 hrs. Nat. \_\_\_\_\_

1st 24 hrs. after shot \_\_\_\_\_

Gas \_\_\_\_\_ Cu. Ft.

Dry Hole \_\_\_\_\_

Abandoned \_\_\_\_\_

Date

APR 14 1948 19

S. J. LEWIS Scor

Map No. 23 Sec. 17 Twp. 21 R. 4E

Well No. 23 Reamey

C R A

Company

**COMPLETE**

Contractor

C S L S E S E

E 11, 1376

SECTION PLAT

         Ft. from N. Line

330 Ft. from S. Line

         Ft. from E. Line

660 Ft. from W. Line

			0

Marion County

Location                                 

Rig up                                 

Drilling and Remarks:

*Vista 2391*  
*5" @ 2391*  
*1000 acid*  
*Pump 15 oil 100*  
*26 3/4*

RECORD

Cased          in.,          ft.

Sand                                 

Gas                                 

Oil                                  ✓

Total Depth 2401

PRODUCTION

1st 24 hrs. Nat.                         

1st 24 hrs. after shot                         

Gas                          Cu. Ft.

Dry Hole                         

Abandoned                         

Date

MAY 12 1948

S. J. LEWIS Scout