


Section 17 Township 21 Range 4-E

Well No. #25 Reamey

Company CRA

Sellers Pool

NORTH

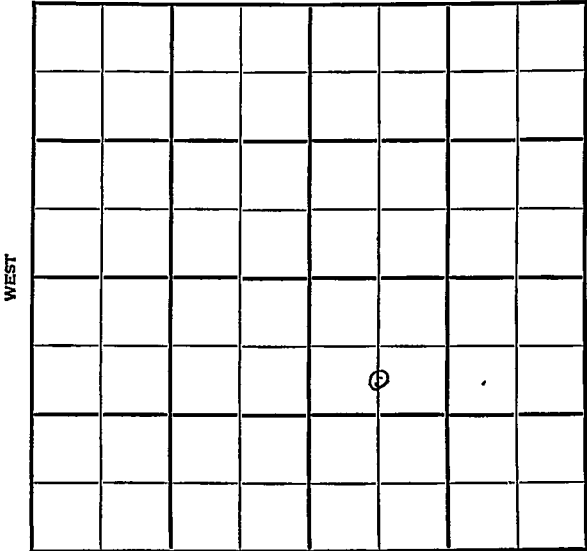

SOUTH

KANSAS

Marion

Sec. 17 Twp. 21 R. 4E

Well No. #25 Reamey Farm

C R A

Company

Sellers Pool


990' Ft. from N. Line

Ft. from S. Line

Ft. from E. Line

660' Ft. from W. Line

C S L NW SE

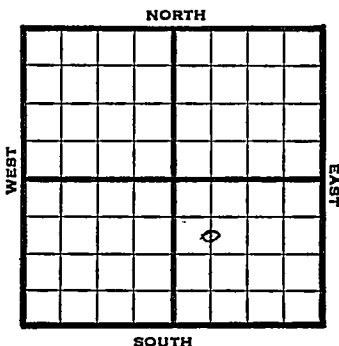

1948

Elev 1372'

REPORT

5/26

Location

6/1

8" @ 115'
Drlg. 190'

6/9

Lansing 1763'
KC 2003'
Viola 2397'
TD 2408'

6/16

5" @ 2398'
TD 2408'
Viola 2397'
5" @ 2398'
Pump 40 Oil Pot
38⁰ Gr.
Comp.

COMPLETED

Map No. _____ Sec. 17 Twp. 21 R. 4E

Well No. 25 Reamey

C R A

Company

FIRST REPORT

Contractor

C S L NW SE

SECTION PLAT

990 Ft. from N. Line

_____ Ft. from S. Line

_____ Ft. from E. Line

660 Ft. from W. Line

		a	

Marion County

Location X

Rig up _____

Drilling and Remarks:

RECORD

Cased _____ in., _____ ft.

Sand _____

Gas _____

Oil _____

Total Depth _____

PRODUCTION

1st 24 hrs. Nat. _____

1st 24 hrs. after shot _____

Gas _____ Cu. Ft.

Dry Hole _____

Abandoned _____

Date

MAY 26 1948

19

S. J. LEWIS

Scout

Map No. 23 Sec. 17 Twp. 21 R. 4E

Well No. 25 Reamey

C R A

Company

COMPLETE

Contractor

C S L NW SE

E. 1392

SECTION PLAT

990 Ft. from N. Line

 Ft. from S. Line

 Ft. from E. Line

660 Ft. from W. Line

Marion County

Location

Rig up

Drilling and Remarks:

Vid. 2397
5" @ 2398
Pump 40 oil Pat

38° SW

RECORD

Cased in., ft.

Sand

Gas

Oil ✓

Total Depth 2408

PRODUCTION

1st 24 hrs. Nat.

1st 24 hrs. after shot

Gas Cu. Ft.

Dry Hole

Abandoned

Date

JUN 16 1948 19

S. J. LEWIS Scout