

Map No. Sec. Twp. R.

Well No. Farm


..... Company

..... Ft. from N. Line

..... Ft. from S. Line

..... Ft. from E. Line

..... Ft. from W. Line

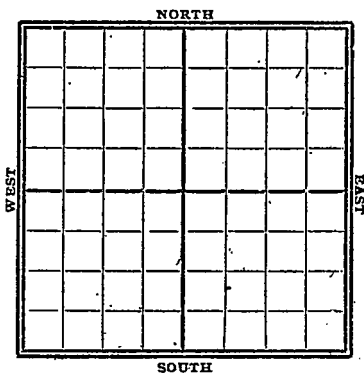

1920

Date

REPORT

Gypsy Records

12/12

Abd T.D. 2520'

Marion

FORM 26 250 BKS. 4-28 WESTERN

K23

MAP No. KANSAS SEC. 17 TWP. 715 R. 4E

WELL No. 1 Sealed

Conte Oil

COMPANY

CONTRACTOR

SECTION PLAT

ABANDONED

_____ FT. FROM N. LINE

_____ FT. FROM S. LINE

_____ FT. FROM E. LINE

_____ FT. FROM W. LINE

	0		

LOCATION _____

RIG UP _____

DRILLING AND REMARKS:

we show 2530

RECORD

CASED _____ IN. _____ FT.

SAND _____

GAS _____

OIL _____

TOTAL DEPTH 2520

PRODUCTION

1ST 24 HRS. NAT. _____

1ST 24 HRS. AFTER SHOT _____

GAS _____ CU. FT.

DRY HOLE

ABANDONED

DATE

Dec 12 1920

SCOUT