

Marion

Map No. Kansas Sec. 17 Twp. 21 R. 4E

Well No. 4 Warner Farm


National Refg Company

_____ Ft. from N. Line

300 Ft. from S. Line

_____ Ft. from E. Line

720 Ft. from W. Line

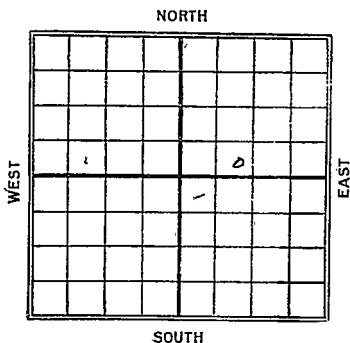

Date

1926

REPORT

FIRST AND COMPLETED

7/29

Top chak 2441-42

340 bbls

mation

23 KANSAS
 Map No. _____ Sec. 17 Twp. 21 R. 4

Well No. 4 Warner
National Refg Co Company

 Contractor

FIRST REPORTS

SECTION PLAT

COMPLETED ² N. Line

300 Ft. from S. Line

_____ Ft. from E. Line

720 Ft. from W. Line

| | | | |
|--|--|----|--|
| | | | |
| | | | |
| | | .6 | |
| | | | |

Location _____

Rig up _____

Drilling and Remarks:

Top Chat 2441-42

340 Bl Retard

RECORD

Cased _____ in., _____ ft.

Sand _____

Gas _____

Oil _____

Total Depth 2442

PRODUCTION

1st 24 hrs. Nat. _____

1st 24 hrs. after shot _____

Gas _____ Cu. Ft.

Dry Hole _____

Abandoned _____

Date

SEP 29 1926

CHAS. L. SHERWOOD

192

Scout