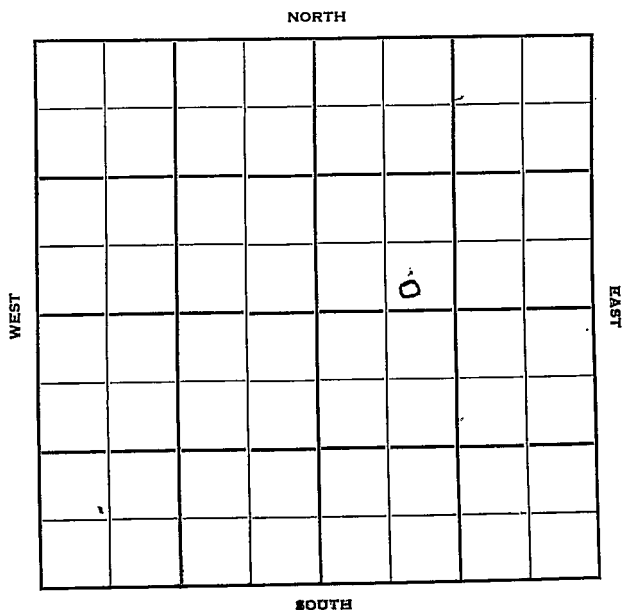


Section 17 Township 21 Range 4EWell No. #1 HarperCompany Eckland Drlg. et al

Marion

KANSAS

Sec. 17 Twp. 21 R. 4 E ✓

Well No. # 1 Harper Farm

Eckland Drlg. et al Company

Contractor


           Ft. from N. Line

200 Ft. from S. Line

           Ft. from E. Line

900 Ft. from W. Line

SE SW NE

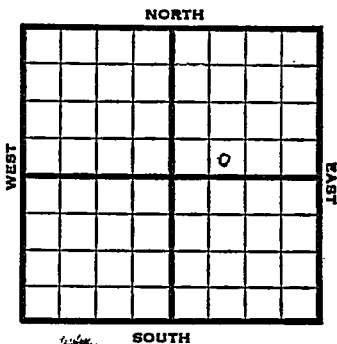

1951

Elev. 1375' REPORT

10/3 Spud 10-2-51  
Drilling

11/21 Spud 10-2-51

Oil well TD 2432

KC 1791 B KC 2138 Miss 2305

TD 2395 5" @ 2395

Viola 2431 TD 2432

FU 100' oil 75 min. B/ 25 BOPD

500 A S/ 26 BO 4 hr. FU 800'  
oil 12 hr.

Comp. 35 BOPD

**COMPLETED**

Sec. **17** (Blk. Twp.) **21** (Sur. Rge.) **4E** Map No.

Well No. 1 Farm Harper

| Elev. | Location | SE | SW | NE |
|-------|----------|----|----|----|
|-------|----------|----|----|----|

[illegible]

200 Ft. From S Line NE

990 Ft. From W Line Quarter

1st. Report OCT 3 1951

### Completion

Remarks

Spudding Date 10-2-51

### Drlg. Data

drig.

J. E. TYRA

County Marion State Kansas  
 Sec. 17 (Blk. 21) (Sur. 4E) Map No. \_\_\_\_\_  
 Operator Eckland Drlg. etal.  
 Well No. 1 Farm Harper  
 Elev. 1375 Location SE SW NE

|  |  |  |  |  |  |
|--|--|--|--|--|--|
|  |  |  |  |  |  |
|  |  |  |  |  |  |
COMPLETE

200 Ft. From S Line NE  
 900 Ft. From W Line Quarter

1st. Report \_\_\_\_\_

Completion NOV 21 1951

Remarks \_\_\_\_\_

Spudding Date 10-2-51

Drlg. Data Oil well TD 2432  
KC 1791 B KC 2138 Miss. 2305  
TD 2395 5" @ 2395 Viola 2431 TD 2432  
FU 100' oil 75 min. B/ 25 bopd 500 A  
S/ 26 bo 4 hr. FU 800' oil 12 hr.  
Comp. 35 bopd

J. E. TYRA