
Marion **KANSAS**

SECTION 18 TOWNSHIP 21 RANGE 3E

WELL NO. #10 Loewen "A"

COMPANY Cities Service

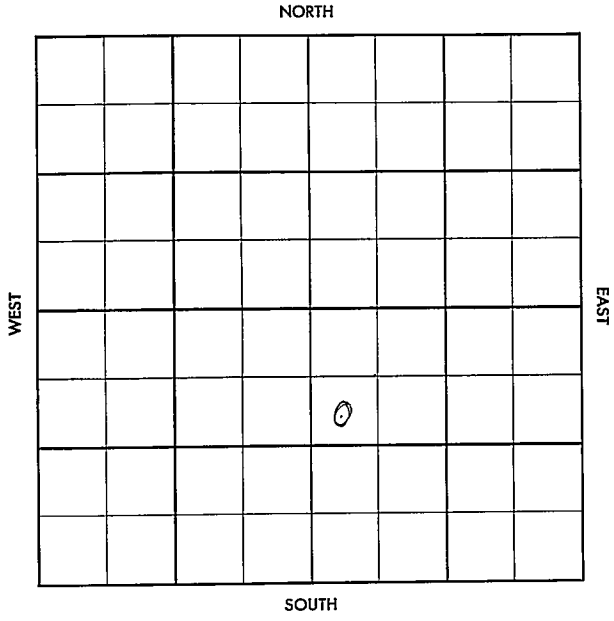

FORM 504-3 SUNRAY

FORM 513 SUNRAY

County Marion Elev.

Sec. 18 Twp. 21 Rge. 3E

Company Cities Service

Farm Name Loewen "A" No. 10

TOPS	DEPTH	LOG	DATUM
Anh.			
Tp.			
H.			
Tr.			
Dg.			
Bl.			
L.			
K.C.			
B.K.C.			
Ce.			
C.			
M.			
M.			
K.			
Mz.			
Mo.			
V.			
S.			
S.			
A			
R.			
P€.			
G.			
T.D.			

Loc. in Sec. SW NW SE

Geol.

Contr. White & Elli

Pool Unger

FIRST REPORT

JAN 3 '57

Date Comm.

8" @ 100/80

Co. Lse No. Sec. T. R.

FORM 513 SUNRAY

County Marion Elev. 1458

Sec. 18 Twp. 21 Rge. 3E

Company Cities Service

Farm Name Loewen "A" No. 10

TOPS	DEPTH	LOG	DATUM
Anh.			
Tp.			
H.			
Tr.			
Dg. Sd	1828		
Bl.			
L.	2035		
K.C.	2154		
B.K.C.	2410		
Ce.			
C.			
M. chert	2601		
M. Li	2648		
K. Base M.	2692		
Mz. Hunt	2840		
Mo.			
V.			
S.			
S.			
A			
R.			
Pe.			
G.			
T.D.	2843		

Loc. in Sec. SW NW SE

Geol.

Contr. White & Ellis

Pool Unger

FEB 13 '57

COMPLETE

Date Comm.

8" @ 100/80 JAN 9 '57 IP 2819

JAN 15 '57 5½ @ 2841/150 CO 2843

FU 1400' oil no/w 90" Pot

JAN 29 '57 JAN 3 '57 P. 330 Bo no/w

24 hrs FEB 6 '57 FEB 13 '57 Ph P.

323 Bopd no/wtr.

Co. Lse. No. Sec. T. R.