


Marion

KANSAS


DX 78-1

Section 18 Township 21 Range 3E
Well No. #9 Lowen "A"
Company C.S.O.

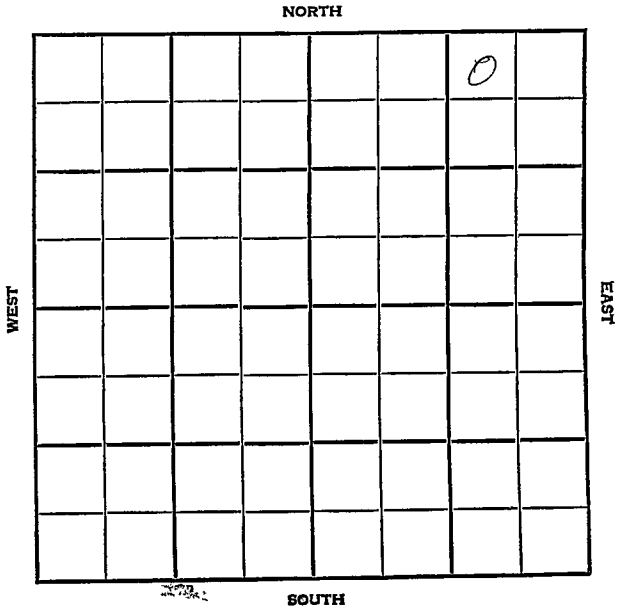

County Marion Elev. _____
 Sec. 18 Twp. 21 Rge. 3E
 Company C. S. O.
 Farm Name Loewen "A" No. 9

TOPS	DEPTH	LOG	DATUM	Loc. in Sec.
Anh.				NW NE NE
Tr.				
H.				
Tr.				
Dg.				
Bl.				
L.				Geol.
K.C.				
B.K.C.				Contr.
Ce.				White & Ellis
C.				Tools
M.				Pool
M.				
K.				Unger
Mz.				
Mo.				
V.				
S.				
S.				
A.				
R.				
Pe.				
G.				
T.D.				

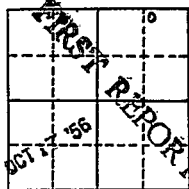

Date Comm. _____

MIRT

0001 1 2 100

G. A

[Handwritten signature]

County Martion Elev. _____
 Sec. 18 Twp. 21 Rgs. 3E
 Company C. S. O.
 Farm Name Loewen #A No. 9

TOPS	DEPTH	LOG	DATUM	Loc. in Sec.
Anh.				NW NE NE
Tr.				
H.				
Tr.				
Dg.	1790			
Bl.				
L.	1996			Geol.
K.C.	2128			Contr.
B.K.C.	2373			White & Ellis
Ce.				Tools
C.				Pool
M. <u>Chert</u>	2559			Unger
M. <u>LI</u>	2634			
K.				
M. <u>HUNT</u>	2803			
Me.				
V.				
S.				
S.				
A.				
R.				
PE.				
G.				
TD.	2804			

	X	10
	NOV 23 '56	
COMPLETE		

Date Comm.

MIRT OCT 24 '56 10-16-56 8578

105/100 @ 2730 OCT 31 '56

5 1/2 @ 2804/150 DD 2805 8

118 B0 nolw 14 hrs NOV 7 '56 POP

NOV 13 '56 P. 105 B0 24 hrs

NOV 21 '56 Ph P. 101 B0pd nolw