


DX 78-1 Marion

Section 18 Township 21S Range 3E

Well No. #2 Lowen "C" (Lowen)

Company Cities Service

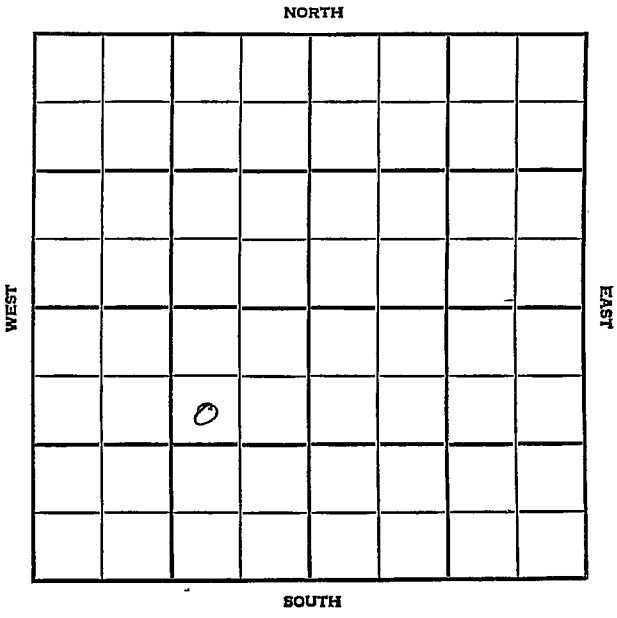

Marion

KANSAS

SEC.	TWP.	R.
18	21	3E

WELL NO.

#2 Loewen "C"

FARM

COMPANY

Cities Service

CONTRACTOR

White & Ellis

Unger


_____ FT. FROM N. LINE

_____ FT. FROM S. LINE

_____ FT. FROM E. LINE

_____ FT. FROM W. LINE

SW NE SW

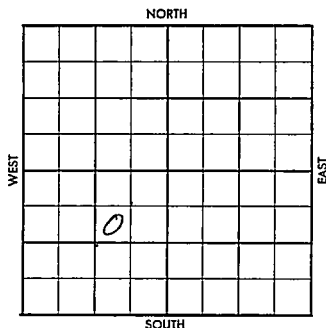

1956	ELEVATION	REPORT
------	-----------	--------

8-29

Comm. 8-28-56

County	Marion	Elev.		Co.
Sec.	18	Twp.	21S	
Company	Cities Service	Rge.	3E	
FarmName	Loewen "C"	No.	2	

TOPS	DEPTH	LOG	DATUM	Loc. in Sec.
Anh.				SW NE SW
Tr.				
H.				
Tr.				
Dg.				
BL.				
L.				Geol.
K.C.				Contr. White
B.K.C.				& Ellis
Ce.				
C.				Pool
M.				Unger
M.				
K.				
Mz.				
Me.				
V.				
S.				
S.				
A				
R.				
Pe.				
G.				
T.D.				

FIRST REPORT

AUG 29 '56

Date Comm. 8-28-56

2 932

County	Marion	Elev.		Co.
Sec.	18	Twp.	21S	Rge.
Company	Cities Service			
FarmName	Loewen "C"	No.	2	

TOPS	DEPTH	LOG	DATUM	Loc. in Sec.
Anh.				SW NE SW
Ip.				
H.				
Tr.				
Dg.	30	1828-1942		
Bl.				
L.		2038		Geol.
K.C.		2170		Contr. White
B.K.C.		2416		& Ellis
Ce.				
C.				Pool
M.		2621		Unger
M.				
K.				
Mz.		2824 1/2		
Mq.	HUNT	2825		
V.				
S.				
S.				COMPLETE
A.				
R.				
PE.				
G.				
TD.		2840		

Date Comm. 8-28-56 SEP 5 '56

8578 104/70 D 2690 SEP 12 '56
 DST 2826-40 1hr rec
 2650' oil + 100' Md 1010/20
 5 1/2 @ 2826/150 19 '56 CO 2840
 8 96 B0 no/w 5 hrs SEP 26 '56
 OCT 3 '56 Draw down 3000 Bopd
 no/w