

Marion


KANSAS

SECTION 18 TOWNSHIP 21 RANGE 3E

WELL NO. #3 Loewen "C"

COMPANY C S O

NORTH

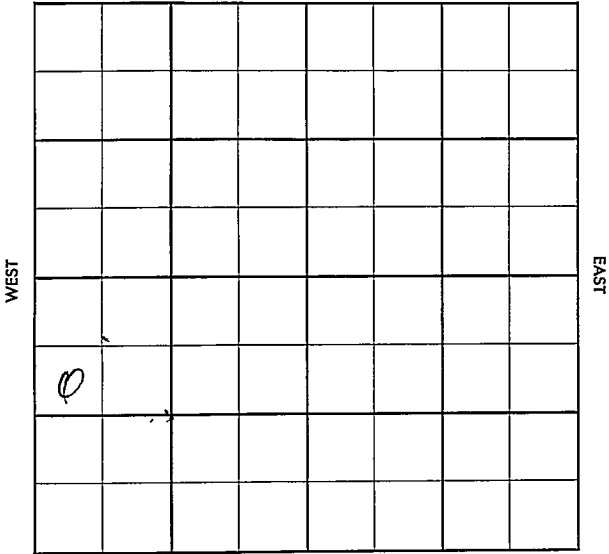

SOUTH

County Marion Elev. _____
 Sec. 18 Twp. 21 Rge. 3E
 Company G/S/O
 Farm Name Loewen "C" No. 3

TOPS	DEPTH	LOG	DATUM
Anh.			
Tr.			
H.			
Tr.			
Dg.			
Bl.			
L.	<u>2642</u>		
K.C.	<u>2168</u>		
B.K.C.	<u>2418</u>		
Ce.			
C.			
M. <u>Chert</u>	<u>2622 11</u>		
M. <u>11</u>	<u>2676</u>		
K. <u>Base</u>	<u>2628 2694</u>		
Me. <u>Hunt</u>	<u>2845</u>		
Mo. <u>MZ</u>	<u>2844 1/2</u>		
V. <u>Hunt</u>	<u>2845</u>		
S.			
S.			
A.			
R.			
Pe.			
G.			
T.D.	<u>2846</u>		

Loc. in Sec. SW NW SW

Geol. _____

Contr. White & Ellis

TOOLS

Pool _____

Unger _____

COMPLETE

NOV 23 '56

Date Comm. _____

Location OCT 17 '56 10-10-56 85/8

105/90. 5/2 @ 2846 OCT 24 '56 DD

2847 FO 2000' oil no/w 8wa

OCT 31 '56 P. 116 B0 no/w 24

Nov 7 '56 S. 11 NOV 13 '56 NOV 21 '56

Ph P. 117 Bopd no/w t.

Co. No. Sec. T. R.