


Marion

KANSAS

SECTION 18 TOWNSHIP 21 RANGE 3E

WELL NO. #4 Loewen "C"

COMPANY C.S. O.

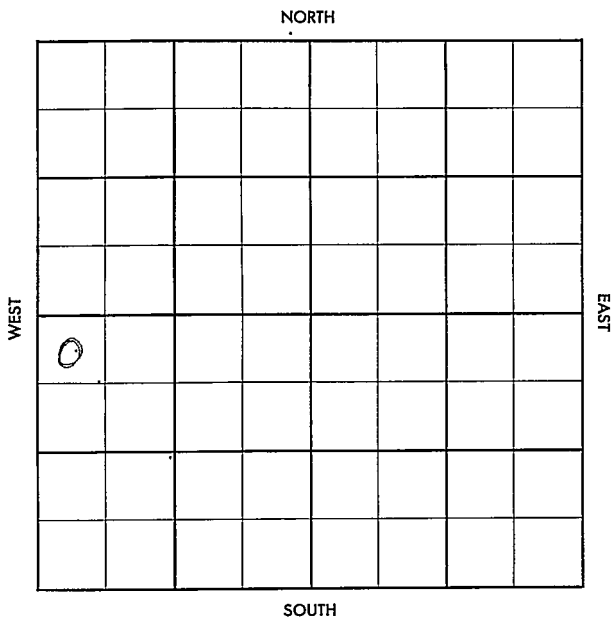

County	Marion			Elev.	
Sec.	18	Twp.	21	Rgs.	3E
Company	C. S. O.				
Farm Name	Loewen "C"			No.	4

TOPS	DEPTH	LOG	DATUM	Loc. in Sec.
Anb.				NW NW SW
Tr.				
H.				
Tr.				
Dg.				
BL.				
L.				Geol.
K.C.				
B.K.C.				Contr.
Ce.				White & Ellis
C.				Tools
M.				Pool
M.				Unger
K.				
Mz.				
Me.				
V.				
S.				
S.				
A.				
R.				
Pe.				
G.				
T.D.				

Sec.

Tools

Pool

Unger

DEC 28 1956

FIRST REPORT

No.

Date Comm. _____ In _____

Location

10

County Marion Elev. 1465
 Sec. 18 Twp. 21 Rge. 3E
 Company C. S. G.
 Farm Name Loewen "C" No. 4

TOPS	DEPTH	LOG	DATUM	Loc. in Sec.
Anb.				17' NW SW
Tr.				70' S
H.				
Tr.				
Dg.				
Bl.				
L.				Geol.
K.C.				Contr.
B.K.C.				White & Ellis
Ce.				TOOL
C.	2610			Pool
M.	2644			Unger
M.	2673			
K-Base M	2821-33			
Mz.	2884			
Me-HUNT				
V.				
S.				
S.				
A.				
R.				
PE.				
G.				
TD.	2905			

COMPLETE
 JAN 30 '57

Date Comm. 12-23-56
 Location JAN 2 '57 Cored 2817-48 run
2817 DST 2822-45 15" 2200'
517 + 30' OCM BHP 1000 DST
2882-88 1hr 2' MFW BHP 0
Rng 5 1/2 @ JAN 8 '57 5 1/2 @
2886/150 CO 2860 25' 2821-25
P. 120 Bo no/w 11hr
JAN 10 '57 P. 371.2 Bo no/w 24
hr no/w 24
draw down 3000 Bopd no/w