


Section 18 Township 21 Range 3 E

Well No. #2 Edwards

Company E. K. Carey

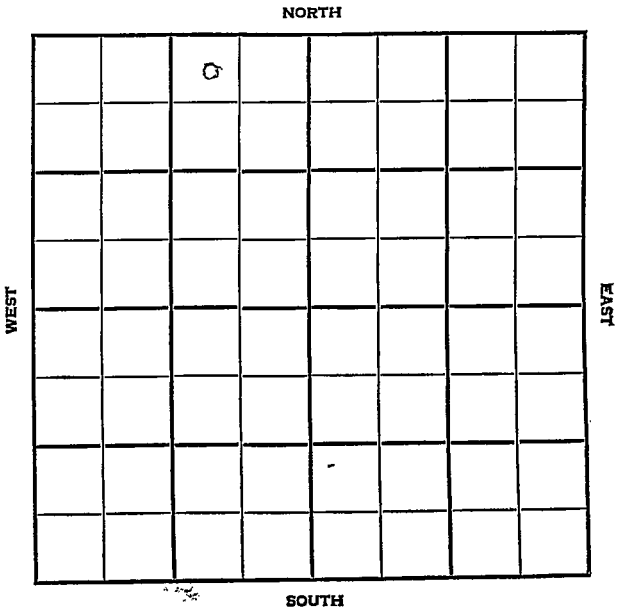

Marion

KANSAS

SEC.	TWP.	R.
18	21	3E

WELL NO.

#2 Edwards

FARM

COMPANY

E.K. Carey

CONTRACTOR

Co. Tools

Unger


Ft. from N. Line

Ft. from S. Line

Ft. from E. Line

Ft. from W. Line

NW NE NW

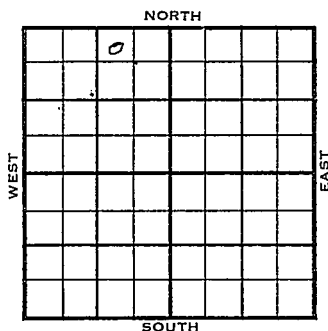

1956

ELEVATION

1432'

REPORT

3-14

8" @ 125/85

4-11

Comm. ~~3-13-56~~ 3-13-56

8" @ 125 w/85

5 1/2" @ 2820

CO to 2821

DD 2824, 250 A

S/ 16 1/2 boph,

Comp. 365 bopd, 16% wtr.

Lsg. 2026

C. 2597

M. 2602

K. 2672

Mz. 2818


Hunt 2819

TD 2824

COMPLETED

County Marion Elev. _____
 Sec. 18 Twp. 21 Rge. 3E
 Company E. K. Carey
 Farm Name Edwards No. 2

TOPS	DEPTH	LOG	DATUM	Loc. in Sec.
Anh.				NW NE NW
Tr.				
H.				
Tr.				
Dg.				
Bl.				
L.				Geol.
K.C.				Contr.
B.K.C.				Co. tools
Ce.				Pool
C.				Unger
M.				
M.				
K.				
Mz.				
Me.				
V.				
S.				
S.				
A.				
R.				
Pe.				
G.				
T.D.				

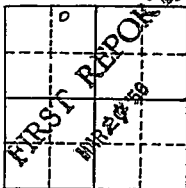

Date Comm.

MAR 14 1956

8" @ 125/85

County Marion Elev. 1432
 Sec. 18 Twp. 21 Rge. 3E
 Company E. K. Carey
 Farm Name Edwards No. 2

TOPS	DEPTH	LOG	DATUM
Anh.			
TP.			
H.			
Tr.			
Dg.			
BL.			
L.			
K.C. <u>659</u>	<u>2026</u>		<u>599</u>
B.K.C.			
Ce.			
C.	<u>2597</u>		<u>1165</u>
M.	<u>2602</u>		<u>1170</u>
M.			
K.	<u>2672</u>		<u>1240</u>
Mz.	<u>2818</u>		<u>1386</u>
Mq. <u>Hunt</u>	<u>2819</u>		<u>1387</u>
V.			
S.			
S.			
A.			
R.			
PE.			
G.			
T.D.	<u>2821</u>		

Loc. in Sec. _____

NW NE NW

Geol. _____

Contr. _____

Co. tools _____

Pool _____

Unger _____

COMPLETE

Date Comm. 3-13-56 APR 1 1 1956

8" @ 125/85 5 $\frac{1}{2}$ " @ 2820 CO to 2821

DD 2824 250 A S/ 16 $\frac{1}{2}$ boph

Comp. 385 bopd 16% w tr.