


Marion

KANSAS
3E

SECTION 18 TOWNSHIP 21 RANGE _____

WELL NO. #3 Good "B"

COMPANY Cities Service

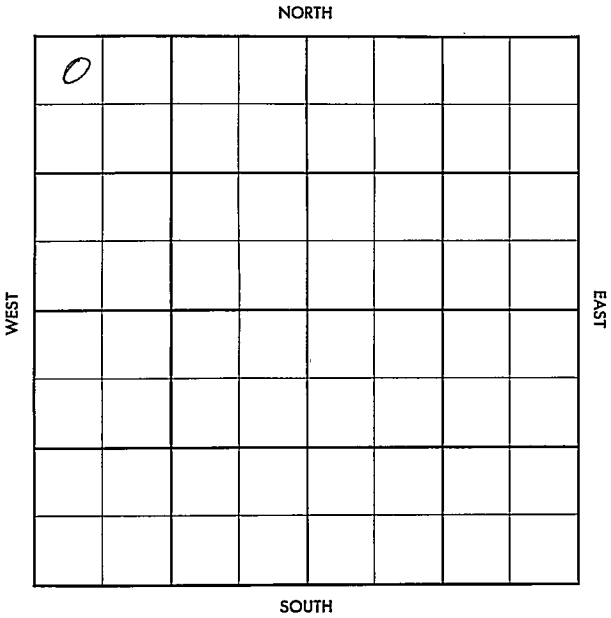

Marion


KANSAS

SEC. 18	TWP. 21	R. 3E
------------	------------	----------

WELL NO. #3 Good "B" FARM

COMPANY
Cities Service

CONTRACTOR
Unger

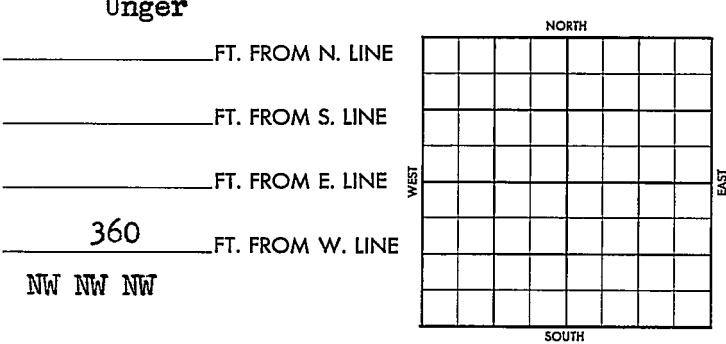

1956	ELEVATION 1141'	REPORT
------	--------------------	--------

5-23 8 " @ 108 w/165

5-29 5 1/2" @2831

6-6 DD TD 2836' 250A

P/ 90 bo / trc., 19 hrs.

6-13 P/ 112 bo / 2 bw, 24 hrs.

6-20 P/ 114 bopd / 1% wtr.

M. 2605', Base 2689', Sd. 2830'

Hunt 2830 1/2'

TD 2832'

COMPLETED

County Marion Elev. _____
 Sec. 18 Twp. 21 Rge. 3E
 Company Cities Service
 Farm Name Good "B" No. 3

TOPS	DEPTH	LOG	DATUM
Anh.			
Tp.			
H.			
Tr.			
Dg.			
Bl.			
L.			
K.C.			
B.K.C.			
Ce.			
C.			
M.			
M.			
K.			
Mz.			
Me.			
V.			
S.			
S.			
A.			
R.			
Pe.			
G.			
T.D.			

Loc. in Sec. NW NW NW
360' WL
 Geol. _____
 Contr. _____
 Pool Unger

0		
FIRST REPORT		
MAY 23 '56		

Date Comm. 8" @ 108/165

2221 P. S. YAN

1 2 9

Co.
Lse.
No.
Sec.
T.
R.

