

Marion


KANSAS

SECTION 18 - TOWNSHIP 21 RANGE 3E

WELL NO. #6 Loewen

COMPANY Cities Service

NORTH

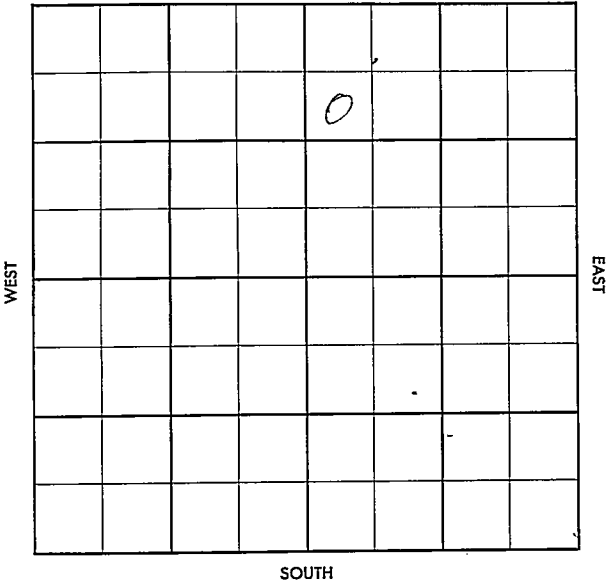

Marion

SEC. 18	TWP. 21	R. 3E
------------	------------	----------

WELL NO.

#6 Loewen

FARM

COMPANY

Cities Service

CONTRACTOR

White & Ellis

Unger


Ft. from N. Line

Ft. from S. Line

Ft. from E. Line

Ft. from W. Line

SW NW NE

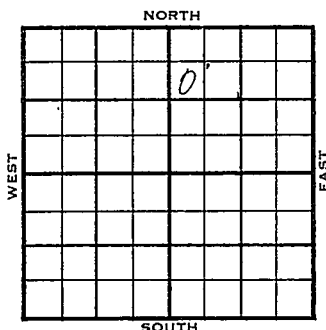

1956

ELEVATION

1139'

REPORT

5-16

Comm. 5-14-56

8" @ 110

Drlg. 800

5-23

5½" @2823

5-29

DD 2834

P/ 107 bo / 5 bw /12 hrs.

6-6

DD TD 2834'

P/ 150 bo / 5 bw /24 hrs.

6-13

P/ 138 bo / 2 bw /24 hrs.

6-20

P/ 148 bopd, no/wtr.

Dg. 1795', L. 2020', K.C. 2132',

B.K.C. 2361', M. 2590', Base 2676',

Hunt 2823'

TD 2825'

COMPLETED

County Marion Elev. _____
 Sec. 18 Twp. 21 Rge. 3E
 Company Cities Service
 FarmName Loewen No. 6

TOPS	DEPTH	LOG	DATUM	Loc. in Sec.
Anh.				SW NW NE
TP.				
H.				
Tr.				
Dg.				
BL.				
L.				Geol. _____
K.C.				Contr. _____
B.K.C.				White & Ellis
Ce.				Pool
C.				Unger
M.				
M.				
K.				
Mz.				
Mq.				
V.				
S.				
S.				
A.				
R.				
PE.				
G.				
T.D.				

Date Comm. 5-11-56
8" @ 110/ drle. 800

MAY 16 1956

20.0

County Marion Elev. 1439
 Sec. 18 Twp. 21 Rge. 3E
 Company Cities Service
 Farm Name Loewen No. 6

TOPS	DEPTH	LOG	DATUM	Loc. in Sec.
Ann.				SW NW NE
Tr.				
Dg.	1795			
Bl.				
L.	2020			Geol.
K.C.	2132			Contr.
RKC.	2361			White & Ellis
Ce.				Pool
C.				Unger
M.	2590			
M. Base	2676			
K. Hoot	2823			
Mz.				
Mo.				
V.				
S.				
S.				
A.				
R.				
Pe.				COMPLETE
G.				
TD.	2825			

Date Comm. 5-11-56 JUN 20 1956

8" @ 110/ drl. 800 MAY 23 '56 5 1/2 @

2824 MAY 29 '56 DD 2834 N4 P.

107 BO + 5 BW 12 hrs. JUN 6 '56

DDTP 2834 P 140 BO + 5 BW / 24

JUN 13 '56 P 138 BO + 2 BW / 24 JUN 20 '56

Ph P. 148 BO pd no water.