


DX 78-1 Marion

KANSAS

Section 18 Township 21 Range 3E

Well No. #8 Good "B"

Company Cities Service

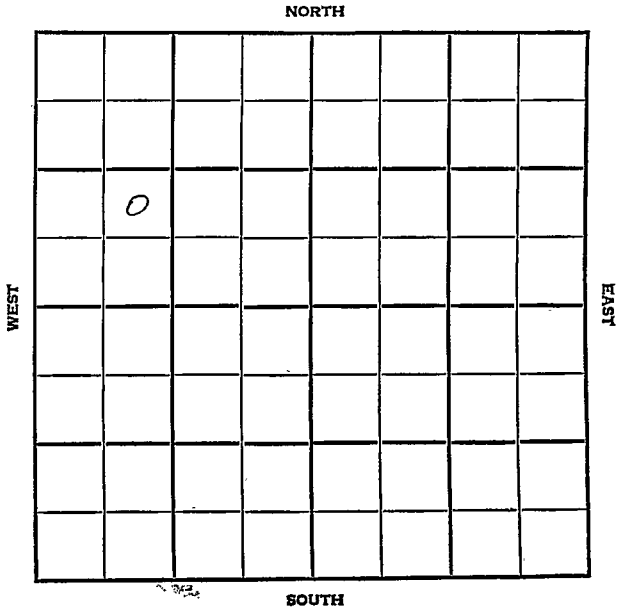

DUPLICATE

Marion

KANSAS


SEC. 18	TWP. 21	R. 3E
------------	------------	----------

WELL NO. #8 Good "B" FARM

COMPANY
Cities Service

CONTRACTOR
White & Ellis Unger

_____ FT. FROM N. LINE
 _____ FT. FROM S. LINE
 _____ FT. FROM E. LINE
 1060 _____ FT. FROM W. LINE

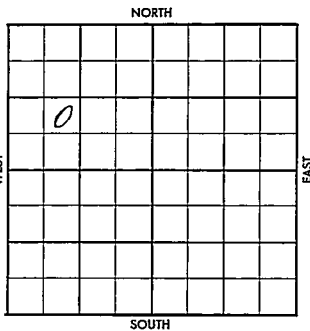

~~###~~ NE SW NW

1956	ELEVATION 1446'	REPORT
------	--------------------	--------

8-1
 Comm. 7-30-56
 8" @ 105 w/100
 Drlg. 965
 D & A
 Dg. 1827'; L. 2042'; KC 2173';
 BKC 2420'; C. 2610'; M. 2644';
 M.Base 2679'; Hunt Erro. 2823';
 V. 2886'; S. 2949';
 TD 2960'

ABANDONED

County Marion Elev. _____
 Sec. 18 Twp. 21 Rgs. 3E
 Company Cities Service
 Farm Name Good "B" No. 8

TOPS	DEPTH	LOG	DATUM
Anh.			
Tp.			
H.			
Tr.			
Dg.			
Bl.			
L.			
K.C.			
B.K.C.			
Ce.			
C.			
M.			
M.			
K.			
Mz.			
Ma.			
V.			
S.			
S.			
A.			
R.			
PE.			
G.			
T.D.			

Loc. in Sec. _____
NE SW NW
1060' WL
 Geol. _____
 Contr. _____
White & Ellis
 Pool _____
Unger
 FIRST REPORT

Date Comm. 7-30-56 AUG 1 1956
8" @ 105/100 drlg. 965

(Faint handwritten notes and a large scribble)

Co. _____
 L# _____
 No. _____
 Sec. _____
 T. _____
 R. _____

County Marion Elev. 1476

TOPS	DEPTH	LOG	DATUM
Anh.			
Top.			
H.			
Tr.			
Dg.	<u>1827</u>		
Bl.			
L.	<u>2042</u>		
K.C.	<u>2173</u>		
B.K.C.	<u>2420</u>		
Ce.			
C.	<u>2610</u>		
M.	<u>2644</u>		
M. <u>Base</u>	<u>2679</u>		
K.			
Mz. <u>Hunt erro.</u>	<u>2823</u>		
Mo.			
V.	<u>2886</u>		
S.	<u>2949</u>		
S.			
A.			
R.			
PE.			
G.			
TD.	<u>2960</u>		

Loc. in Sec. 1050' WL
 Geol. _____
 Contr. White & Miller
 Pool Unger

ABANDONED

Date Comm. 7-30-56 AUG 8 '56
8" @ 105/100 dr. . 965 AUG 8 '56

D&B

Co. No. Sec. T. R.