


Marion

Form 51-5M-11-31-Palace

Map No. KANSAS Sec. 18 Twp. 21 R. 5 E

Well No. 1-A Greely Farm
Lee & Gault Company

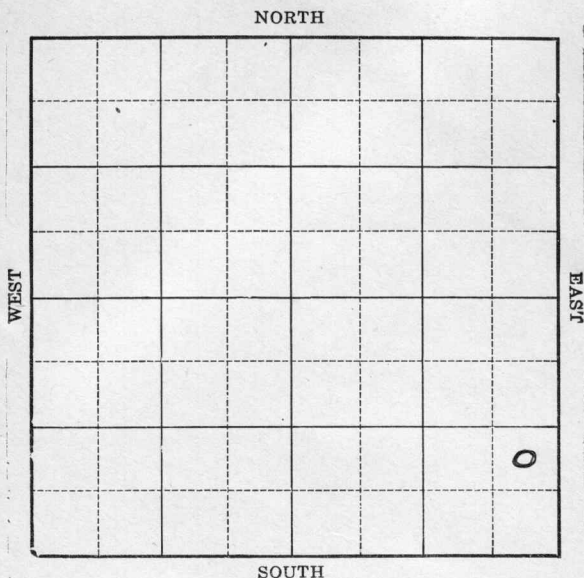

Location

Drilling Remarks

Rig Up

Drilling Remarks

RECORD

Cased in. ft.

Sand

Gas

Oil

Total Depth

PRODUCTION

1st 24 hrs. Nat.

1st 24 hrs. after shot

Gas cu. ft.

Dry Hole

Abandoned

Marion

Map No. KANSAS Sec. 18 Twp. 21 R. 5 E


Well No. 1-A Greeley Farm
Lee & Grant Company

 Ft. from N. Line

990 Ft. from S. Line

330 Ft. from E. Line

 Ft. from W. Line

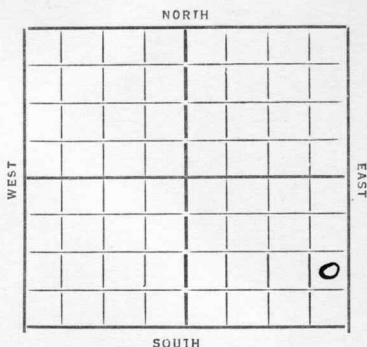

Date 1934

REPORT

4/25 Spud
5/3 SD 1130
5/10 Dlg 1250 12" 100 8" 1160
204 71 960
5/18 Dlg 1675 6" 1569.
5/25 T.K.C. 1704 Pay 1714.18
1755 TD acidize
5/31 Dlg 1755
6/7 —
6/14 SD 1755
6/21 — 6/28 —
7/5 KCL 1704 5" 2150
TV 2349 TD 2350 S.O.
Acidizing
7/12 UR 5"
7/19 Frg.
7/26 — 8/2 — 8/9 —
8/16 — 8/23 — 8/30 —
9/6 — 9/13 —
9/19 Viola 2349 TD 2355
1000 acid 94 Bbls.

COMPLETED

Map No. 23 Sec. 18 Twp. 21 R. 5E

Well No. 1A - Grady

Lee + Grant Company

Contractor

FIRST REPORTS

Ft. from N. Line

990 Ft. from S. Line

330 Ft. from E. Line

Ft. from W. Line

SECTION PLAT

			0

Location

Rig up

Drilling and Remarks:

RECORD

Cased in., ft.

Sand

Gas

Oil

Total Depth

PRODUCTION

1st 24 hrs. Nat.

1st 24 hrs. after shot

Gas Cu. Ft.

Dry Hole

Abandoned

Date

4-25-31

19

ORVAL MANNSCHRECK Scout

Map No. 23 Sec. 18 Twp. 21 R. 5EWell No. 1A-Grady
See & Grant Company

Contractor

COMPLETED

SECTION PLAT

			0

Ft. from N. Line

990 Ft. from S. Line330 Ft. from E. Line

Ft. from W. Line

Location

Rig up

Drilling and Remarks:

1000 and94 bbls

RECORD

Cased in. ft.Sand Viola 2349

Gas

Oil

Total Depth 2355

PRODUCTION

1st 24 hrs. Nat.

1st 24 hrs. after shot

Gas Cu. Ft.

Dry Hole

Abandoned

Date

9-19-34 192ORVAL MANNSCHRECK
Scout