

Lyon


KANSAS

SECTION 18 TOWNSHIP 21 RANGE 12 E

WELL NO. #1 Claus Voghts

COMPANY D. A. McDonald et al

NORTH

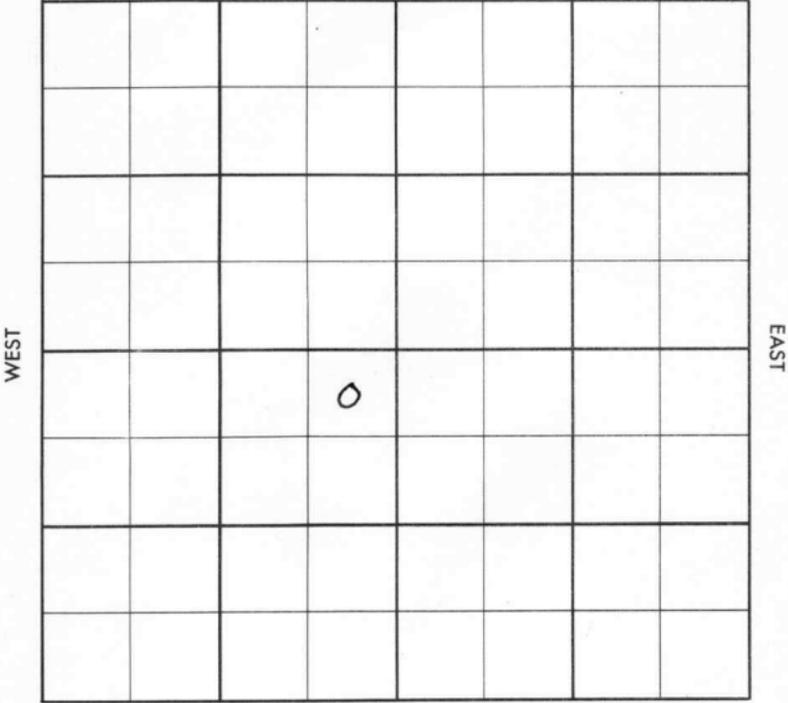

SOUTH

Lyon

KANSAS

SEC.	TWP.	R.
18	21	12 E

WELL NO.

1 Claus Voghts

FARM

COMPANY

D. A. McDonald et al

CONTRACTOR

Geneva


Wildcat

_____ Ft. from N. Line

_____ Ft. from S. Line

_____ Ft. from E. Line

_____ Ft. from W. Line

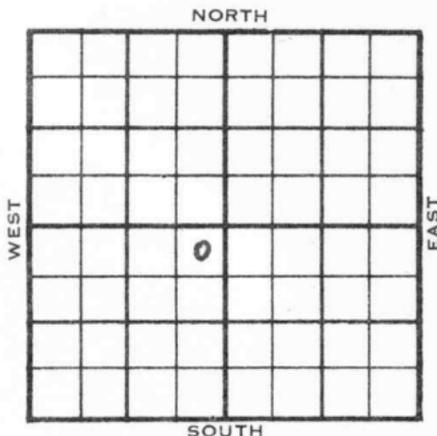

NE NE SW

ELEVATION

REPORT

1955

10/26

Comm. 9-15-55 TD 2031' D & A
 Tops: Dg 947', L. 1035', B KC 1218'
 Bart 2000'

FIRST REPORT

J

ABANDONED

No County

County Lyon Elev. _____
 Sec. 18 Twp. 21 Rge. 12E
 Company D. A. McDonald etal.
 FarmName Claus Voghts No. 1

TOPS	DEPTH	LOG	DATUM
Anh.			
Tp.			
H.			
Tr.			
Dg.	<u>917</u>		
Bl.			
L.	<u>1035</u>		
K.C.	<u>1218</u>		
B.K.C.			
Ce.			
C. <u>Bart.</u>	<u>2000</u>		
M.			
M.			
K.			
Mz.			
Ma.			
V.			
S.			
S.			
A.			
R.			
Pe.			
G.			
T.D.	<u>2031</u>		

Loc. in Sec. NE NE SW
 Geol. _____
 Contr. _____
Geneva
 Pool Wildcat

FIRST REPORT
 OCT 26 '55
 ABANDONED

Date Comm. 9-15-55
D & A

Co.
 Lse.
 No.
 Sec.
 T.
 R.