


Section 19 Township 21 Range 3E

Well No. #2 Slocombe

Company Anderson-Prichard

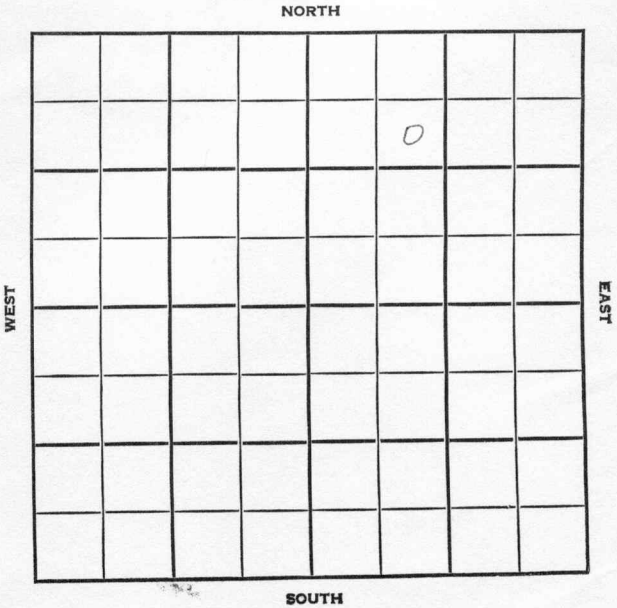

County Marton Elev. _____
Sec. 19 Twp. 21 Rge. 3E
Company Anderson-Prichard
Farm Name Slocomb No. 2

TOPS	DEPTH	LOG	DATUM
Anh.			
Tp.			
H.			
Tr.			
Dg.			
BL.			
L.			
K.C.			
B.K.C.			
Ce.			
C.			
M.			
M.			
K.			
Mz.			
Me.			
V.			
S.			
S.			
A.			
R.			
Pe.			
G.			
T.D.			

Loc. in Sec. SE NW NE

Geol. _____
Contr. Peel

Pool SW Unger



Date Comm. M I R

10

AUG 5 1956

24

County Marion Elev. 1451
 Sec. 19 Twp. 21 Rge. 3E
 Company Anderson-Prichard
 Farm Name Slocomb No. 2

TOPS	DEPTH	LOG	DATUM	Loc. in Sec.
Anh.				SE NW NE
Tr.				
H.				
Tr.				
Dg.				
BL.				
L.				Geol.
K.C.				Contr.
B.K.C.				Peel
Ce.				
C.				Pool
M. <u>chert</u>	<u>2624</u>			SW Unger
M.				
K.	<u>2711</u>			
M. <u>Hont</u>	<u>2856</u>			
Me.				
V.				
S.				
S.				
A.				
R.				
Pe.				
G.				
TD.	<u>2861</u>			

COMPLETE		
SEP 12 '56		

Date Comm.

M I R AUG 22 '56 8-14-56 85/8

112/165 DST 2861 AUG 29 '56 2854

-61 in 30" run 17' Md

BHPD 5 1/2 @ 2859/100 co

2861 TD FU 2200' oil 30"

FU 2600' oil 1hr. PDP SEP 5 '56

P. 186 Bopd + 6 BW 24 hrs SEP 12 '56

Ph P. 208 Bopd + 440 wth

graw 38.6°

Marion

KANSAS

SEC.

19

TWP.

21

R.

3E

WELL NO.

#2 Slocomb

FARM

COMPANY

Anderson-Prichard

CONTRACTOR

Peel

SW Unger


____ FT. FROM N. LINE

____ FT. FROM S. LINE

____ FT. FROM E. LINE

____ FT. FROM W. LINE

SE NW NE

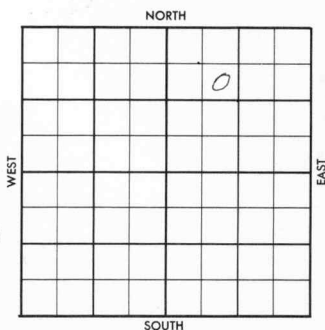

1956

ELEVATION

REPORT

8-15

MIR

COMPLETED