


SECTION 19 TOWNSHIP 21 RANGE 3E

WELL NO. #4 L.D. Slocombe

COMPANY Anderson-Prichard

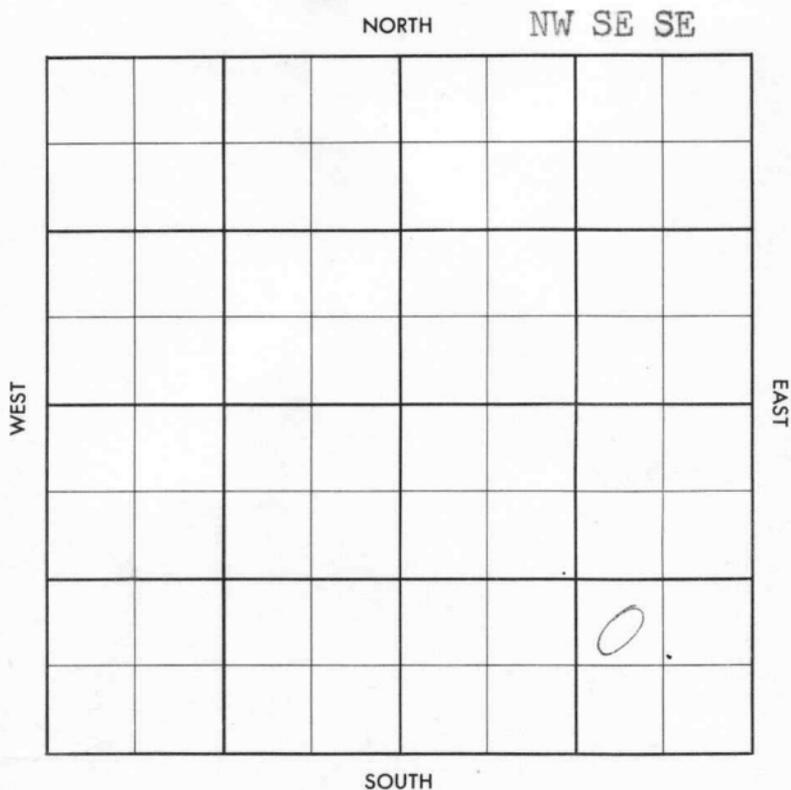

County Marion Elev. _____
 Sec. 19 Twp. 21 Rge. 3E
 Company Anderson-Prichard
 Farm Name L. D. Slocombe No. 4

TOPS	DEPTH	LOG	DATUM
Anh.			
Tp.			
H.			
Tr.			
Dg.			
Bl.			
L.			
K.C.			
B.K.C.			
Ce.			
C.			
M.			
M.			
K.			
Mz.			
Mo.			
V.			
S.			
S.			
A.			
R.			
PE.			
G.			
T.D.			

Loc. in Sec. NW SE SE
 Geol. _____
 Contr. Peel Bros.
 Pool _____
Unger

MAY 8 37		
FIRST REPORT		
		0

Date Comm. WORT

[Handwritten scribble]

Co.

Use.

No.

Sec.

T.

R.

County Marion Elev. 1449
 Sec. 19 Twp. 21 Rge. 3E
 Company Anderson-Prichard
 Farm Name L. D. Slocombe No. 4

TOPS	DEPTH	LOG	DATUM	Loc. in Sec.
Anh.				NW SE SE
Tp.				
H.				SE
Tr.				
Dg.				
BL.				
L.				Geol.
K.C.				Contr.
B.K.C.				
Ce.				Peel Bros.
C.		2564		
M.		2568		
M.				Pool
K.		2692		
Mz. <u>HUNT</u>		2830		Unger
Mq.				
V.				
S.				
S.				
A.				
R.				
PE.				
G.				
T.D.	2822			

JUN 19 '57
COMPLETE
 0

Date Comm. WORT MAY 15 '57 5-9-57 8578
2191150 @ 2290 MAY 22 '57 DST
2790-2821 1hr 5' Md
BHP @ DST @ 2826-32 1hr
at 50' oil + 55' HSCM BHP
950 5 1/2 2831 / WORT MAY 29 '57
CO DD 2834 @ 10 BF (15% W)
3 hrs @ 10 30 + 182 BW
24 hrs Pst JUN 5 '57 JUN 12 '57 JUN 19 '57
Ph.P. 5 Bopd + 98% wt.

Co.
 Lse.
 No.
 Sec.
 T.
 R.