
DX 78-1

Marion KANSAS

Section 19 Township 21 Range 3E

Well No. #5 Slocombe

Company Anderson-Prichard

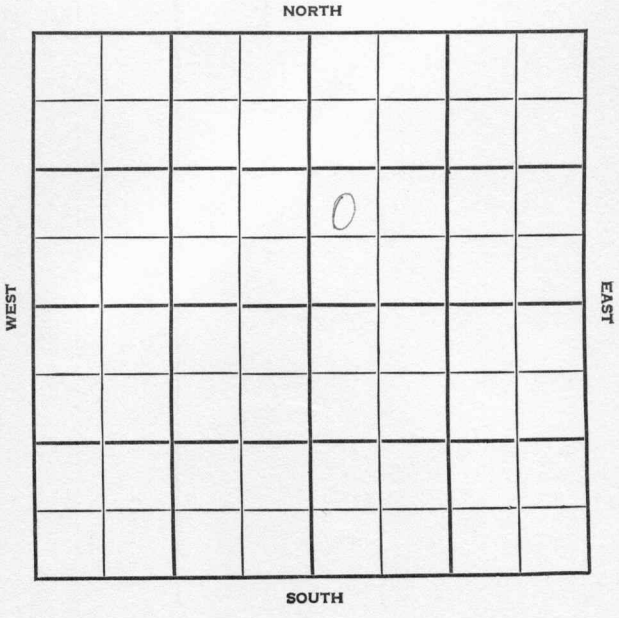

FORM 513 SUNRAY

County Marion Elev.

Sec. 19 Twp. 21 Rge. 3E

Company Anderson-Prichard

Farm Name Slocombe No. 5

TOPS	DEPTH	LOG	DATUM
Anh.			
Tp.			
H.			
Tr.			
Dg.			
B.L.			
L.			
K.C.			
B.K.C.			
Ce.			
C.			
M.			
M.			
K.			
Mz.			
Mo.			
V.			
S.			
S.			
A			
R.			
P€.			
G.			
T.D.			

Loc. in Sec. NW SW NE

Geol.

Contr. Glenn Peel

Pool Unger

JAN 9 '57

FIRST REPORT

Date Comm. 1-6-57

8" @ 122/155 drlg. 870

X O

Co. Lse. No. Sec. T. R.

FORM 513 SUNRAY

County Marion Elev. 1442

Sec. 19 Twp. 21 Rge. 3E

Company Anderson-Prichard

Farm Name Slocombe No. 5

TOPS	DEPTH	LOG	DATUM
Anh.			
Tp.			
H.			
Tr.			
Dg.			
Bl.			
L.		2014	
K.C.			
B.K.C.			
Ce.			
C.			
M.		2575	
M.			
K.		2687	
Mz. Hunt		2837	
Mc.			
V.			
S.			
S.			
A			
R.			
P€.			
G.			
T.D.	2876		

Loc. in Sec. NW SW NE

Geol.

Contr. Glenn Peel

Pool Unger

JAN 30 '57

COMPLETE

Date Comm. 1-6-57

8" @ 122/155 drlg. 870 JAN 28 '57

5½ 2875/ JAN 28 '57 CO 2871

24/2860-66 FU 100' oil + 2250' SW in 3 hrs SQd. CO

24/2838-44 FU 2150' oil in 15" FU 2821' oil/45" & 137 BO in 14 hrs to POP JAN 30 '57

Ph. P. 141 Bo Pd no/wtr

grav 38.5°

Co. Lse. No. Sec. T. R.