



Map No. Kan Sec. 19 Twp. 21 R. 5


Well No. 2 Greeley Farm  
Connell Oil Co Company

..... Ft. from N. Line

1120 Ft. from S. Line

1120 Ft. from E. Line

..... Ft. from W. Line

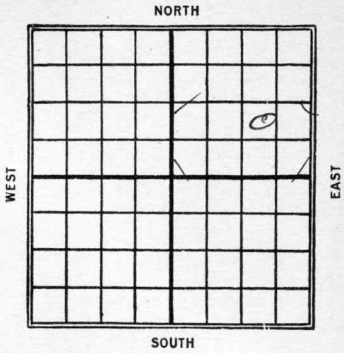

1926

Date

REPORT

Date	REPORT
<u>9/15</u>	<u>Drly 300'</u>
<u>9/22</u>	<u>" 900'</u>
<u>9/29</u>	<u>" 1335'</u>
<u>10/13</u>	<u>S.D. 1335'</u>
<u>10/27</u>	<u>drly 1400'</u>
<u>11/11</u>	<u>" 1825'</u>
<u>11/17</u>	<u>" 2200'</u>
<u>1/23</u>	<u>show oil 2559-H.F.W.</u> <u>D. &amp; A. 2561</u>

*Malton Co*

23 KANSAS  
Map No. \_\_\_\_\_ Sec. *19* Twp. *21* R. *5*


Well No. *2*  
*Correll Oil Co* Company

\_\_\_\_\_  
Contractor

### FIRST REPORTS

### SECTION PLAT

\_\_\_\_\_  
Ft. from N. Line  
*1120*  
Ft. from S. Line  
*1120*  
Ft. from E. Line  
\_\_\_\_\_  
Ft. from W. Line

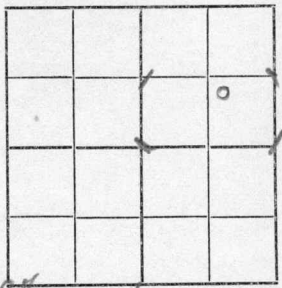

*"Formerly by the acreage"*

Location \_\_\_\_\_

Rig up \_\_\_\_\_

Drilling and Remarks:

*Only 300'*

### RECORD

Cased \_\_\_\_\_ in., \_\_\_\_\_ ft.  
Sand \_\_\_\_\_  
Gas \_\_\_\_\_  
Oil \_\_\_\_\_  
Total Depth \_\_\_\_\_

### PRODUCTION

1st 24 hrs. Nat. \_\_\_\_\_  
1st 24 hrs. after shot \_\_\_\_\_  
Gas \_\_\_\_\_ Cu. Ft.  
Dry Hole \_\_\_\_\_  
Abandoned \_\_\_\_\_

Date \_\_\_\_\_

SEP 15 1926

CHAS. L. SHERWOOD  
Scout

192

*Marion*

*23* KANSAS

Map No. \_\_\_\_\_ Sec. *19* Twp. *21* R. *5*

Well No. \_\_\_\_\_

*Cornell Oil Co* Company

Contractor

COMPLETED

SECTION PLAT

\_\_\_\_\_ Ft. from N. Line

*1120* Ft. from S. Line

*1120* Ft. from E. Line

\_\_\_\_\_ Ft. from W. Line

			<i>0</i>

ABANDONED

Location \_\_\_\_\_

Rig up \_\_\_\_\_

Drilling and Remarks:

*Show oil 2559'*

*AFW*

*Dry 2561*

RECORD

Cased \_\_\_\_\_ in., \_\_\_\_\_ ft.

Sand \_\_\_\_\_

Gas \_\_\_\_\_

Oil \_\_\_\_\_

Total Depth *2561*

PRODUCTION

1st 24 hrs. Nat. \_\_\_\_\_

1st 24 hrs. after shot \_\_\_\_\_

Gas \_\_\_\_\_ Cu. Ft.

Dry Hole

Abandoned

Date

NOV 23 1926

192 **CHAS. L. SHERWOOD** Scout