



Lyon Co

Map No. Kansas Sec. 19 Twp. 21 R. 10

Well No. 1 Morris Farm


C. L. Sheedy Company

330 Ft. from N. Line

\_\_\_\_\_ Ft. from S. Line

\_\_\_\_\_ Ft. from E. Line

330 Ft. from W. Line

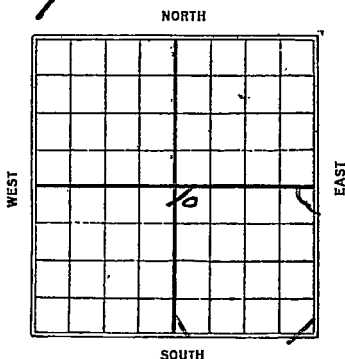

Date	REPORT
1926	
1/20	Timbers
1/27	Rig
3/4	Spudding
3/10	Rep. boiler J.D. 375'
2/17	Drly 1800'
2/24	Ld 1000
3/5	Dly 1275'
3/10	" 1555'
3/18	" 1780
3/25	Set 6" 2185 J.D. 2185-87'
	good show oil S.D.
4/1	Top sand 2185-2210.
	filled up 700 oil in
	12 hours. Drly 2255,
	in shale.
4/7	_____
4/14	Plugging back to 2210.
4/21	_____
4/29	2185-2210, J.D. 2270
	Top line 2270 P.B. 2185-
	2210 60/16 BRLs.

*Hyons Co.*

Map No. *K.21* KANSAS Sec. *19* Twp. *21* R. *10*

Well No. *1* *Moore*  
*@ L Shedd* Company

Contractor

COMPLETED

SECTION PLAT

*330* Ft. from N. Line  
 \_\_\_\_\_ Ft. from S. Line  
 \_\_\_\_\_ Ft. from E. Line  
*330* Ft. from W. Line

		o	

Location \_\_\_\_\_

Rig up \_\_\_\_\_

Drilling and Remarks:

*Top line 2270'*  
*Plugged back to*  
*2185-2210'*  
*log 16 lbs.*

RECORD

Cased \_\_\_\_\_ in., \_\_\_\_\_ ft.  
 Sand *2185-2210'*  
 Gas \_\_\_\_\_  
 Oil \_\_\_\_\_  
 Total Depth *2270'*

PRODUCTION

1st 24 hrs. Nat. \_\_\_\_\_  
 1st 24 hrs. after shot \_\_\_\_\_  
 Gas \_\_\_\_\_ Cu. Ft.  
 Dry Hole \_\_\_\_\_  
 Abandoned \_\_\_\_\_

Date

APR 28 1926

CHAS. L. SHERWOOD  
 Scout

*Huron Co*

*K21* Map No. **KANSAS** Sec. *19* Twp. *21* R. *10*


Well No. *1 Morris*  
*E. L. Shedy* Company

Contractor

**FIRST REPORTS**

**SECTION PLAT**

*330* Ft. from N. Line  
Ft. from S. Line  
Ft. from E. Line  
*330* Ft. from W. Line

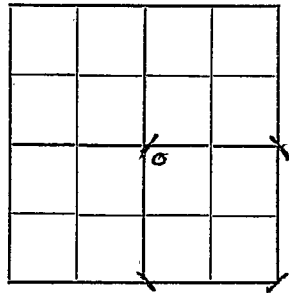

Location -----

Rig up -----

Drilling and Remarks:

*Timber*

**RECORD**

Cased ----- in., ----- ft.

Sand -----

Gas -----

Oil -----

Total Depth -----

**PRODUCTION**

1st 24 hrs. Nat. -----

1st 24 hrs. after shot -----

Gas ----- Cu. Ft.

Dry Hole -----

Abandoned -----

Date

**JAN 20 1926**

**CHAS. L. SHERWOOD**

192

Scout