

Marion

KANSAS

19

21

3E

SECTION _____ TOWNSHIP _____ RANGE _____


#3 Slocombe

WELL NO. _____

Anderson Prichard

COMPANY _____

NORTH

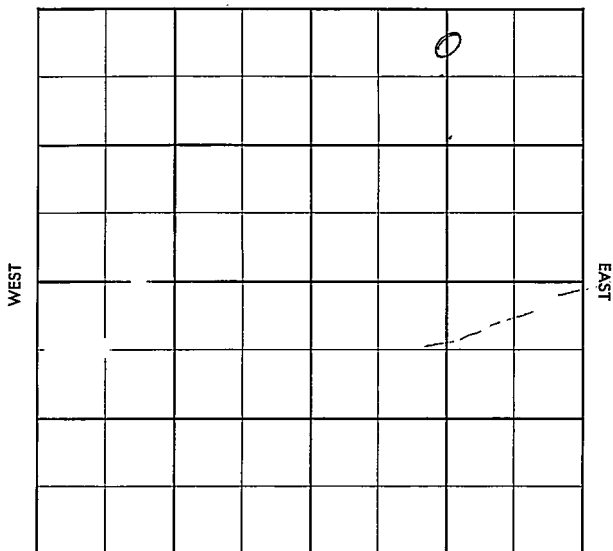

SOUTH

Marion

MARION


SEC.	19	TWP.	21	R.	3E
------	----	------	----	----	----

WELL NO. #3 Slocombe FARM

COMPANY **Anderson Prichard**

CONTRACTOR **Peel Bros Rotary Tools
Unger SW**

_____ FT. FROM N. LINE
 _____ FT. FROM S. LINE
 _____ FT. FROM E. LINE
 _____ FT. FROM W. LINE

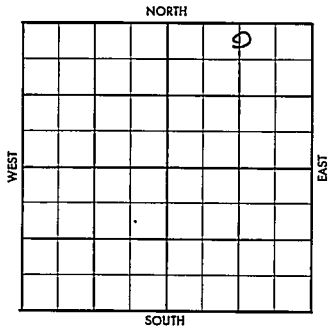

N/2 N/2 NE

1956	ELEVATION	REPORT
------	-----------	--------

9-12
 Comm 9-7-56
 10" @ 121 w/155
 Delg 1950

County Marion Elev. 1447
 Sec. 19 Twp. 21 Rge. 3E
 Company Anderson Prichard
 Farm Name Slocombe No. 3

TOPS	DEPTH	LOG	DATUM	Loc. in Sec.
Anh.				R/2 R/2 NE
Ip.				
H.				
Tr.				
Dg.				
Bl.				
L.				Geol.
K.C.				Contr.
B.K.C.				
Ce.				
C.	<u>2601</u>			Feet Bros. Rod
M.	<u>2622</u>			tary Tools
M.				Pool
K.	<u>2703</u>			
M.	<u>HURT 2849</u>			Unger SW
Ma.				
V.				
S.				
S.				
A.				
R.				COMPLETE
Pe.				
G.				
T.B.	<u>2851</u>			OCT 3 '56

Date Comm. 9/7/56

10" @ 121 w/ 155, Drlg. 1950 SEP 19 '56

7" @ 2849/100 SEP 26 '56 CO 2851

10 25 GO + TR w/ 2 hrs 1/4

P. 29 B0 + 24 BW 9 hrs

10 25 P. 86 B0 pd + 45

to w/ 2 hrs.

County Marion Elev. _____
 Sec. 19 Twp. 21 Rge. 3E
 Company Anderson Prichard
 Farm Name Slocombe No. 3

TOPS	DEPTH	LOG	DATUM	Loc. in Sec.
Anh.				N/2 N/2 NE
Tp.				
H.				
Tr.				
Dg.				
Bl.				
L.				Geol. _____
K.C.				Contr. _____
B.K.C.				
Ce.				Peel Bros. Ro
C.				tary Tools
M.				Pool
M.				Unger SW
K.				
Mz.				
Ma.				
V.				
S.				
S.				
A.				
R.				
Pe.				
G.				
T.D.				

		o
	SEP 12 1956	

FIRST REPORT

Date Comm. 9/7/56
10" @ 121 w/ 155, Drlg. 1950

~~10" @ 121 w/ 155, Drlg. 1950~~