

STATE OF KANSAS
STATE CORPORATION COMMISSION
CONSERVATION DIVISION
800 BITTING BUILDING
WICHITA, KANSAS

WELL PLUGGING APPLICATION FORM

Lease Owner Deep Rock Oil Corporation Address Atlas Life Bldg., Tulsa, Okla.
(Applicant)

Lease (Farm Name) Odaffer Well No. #12

Well Location 1120' N of S,
535' E of W, NW/4 Sec. 14 Twp. 21 Rge. 20 (E)-(W)

County Anderson Field Name (if any) Bush City Shoestring

Total Depth 798' 6" Oil x Gas Dry Hole

Was well log filed with application? No. If not, explain:

This is an old well that was on the property when we acquired same. We
have no log in this well.

Date and hour plugging is desired to begin 8 A.M. 12/8/50.

Plugging of the well will be done in accordance with the Rules and
Regulations of the State Corporation Commission, or with the approval
of the following exceptions: Explain fully any exceptions desired.

(Use an additional sheet if necessary)

Name of the person on the lease in charge of well for owner

Clyde Crozier Address Garnett, Kansas

Name of Plugging Contractor Nickels Drilling Company

Address Garnett, Kansas

Invoice covering assessment for plugging this well should be sent to

Deep Rock Oil Corporation Address Box 127, Osawatomie, Ks.

and payment will be guaranteed by applicant.

PLUGGING
FILE NO. 14-71-200
57-4

RECEIVED
COMMISSION
DEC 28 1950
CONSERVATION DIVISION
Deep Rock Oil Corporation
Applicant or Acting Agent

Date 12/7/50



STATE OF KANSAS
STATE CORPORATION COMMISSION
CONSERVATION DIVISION
800 BITTING BUILDING
WICHITA, KANSAS

December 28, 1950

Well No.	12
Lease	Odaffer
Description	NE SW NW 14-21-20E
County	Anderson
File No.	52-4

Deep Rock Oil Corporation
Box 127
Osawatomie, Kansas

Gentlemen:

This letter is your authority to plug the above subject well, in accordance with the Rules and Regulations of the State Corporation Commission. When you are ready to plug this well, please contact our District Plugging Supervisor, Mr. **A. R. Daniel,** 229 W. 7th, Garnett, Kansas.

STATE CORPORATION COMMISSION
CONSERVATION DIVISION

BY: J. P. Roberts
J. P. ROBERTS

cc: DISTRICT PLUGGING SUPERVISOR

DISTRICT CONSERVATION AGENT'S REPORT

TO:

State Corporation Commission
Conservation Division
800 Bitting Building
Wichita, Kansas

FILE NO. _____

LOCATION NE SW NW

SEC. 14 TWP. 21 RGE. 20

Dry Hole _____ Abandoned Oil Well Yes Abandoned Gas Well _____

I have today completed supervision of plugging of:

Well No. _____ # 12 Lease Odaffer

Operator Deep Rock Oil Corp Address Atlas Bldg., Tulsa, Okla

Field Bush City County Anderson

Total Depth 798 Feet.

(Describe briefly the manner in which the well was plugged)

Cement from 798 to 600
Bridge placed at 175
3 sacks of cement on Bridge
Hole filled to top with soil and leveled with surface

G. P. Daniel
District Conservation Agent
12 26 -50


Date _____

PLUGGING
FILE SEC 14 T 21 R 20E
BOOK PAGE 52 LINE 4

WELL PLUGGING RECORD

Give All Information Completely
Make Required Affidavit
Mail or Deliver Report to:
Conservation Division
State Corporation Commission
800 Biting Building
Wichita, Kansas

NORTH

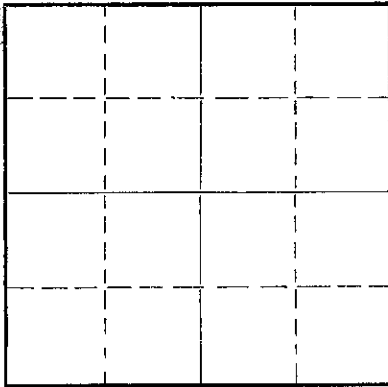

Locate well correctly on above
Section Flat

Anderson County, Sec. 14 Twp. 21 Rge. 20 (E) (W)
Location as "NE/CNW $\frac{1}{4}$ SW $\frac{1}{4}$ " or footage from lines 1120' N of S, 535' E of W, NW $\frac{1}{4}$
Lease Owner Deep Rock Oil Corporation
Lease Name Odaffer Well No. #12
Office Address Atlas Life Bldg., Tulsa 2, Oklahoma
Character of Well (completed as Oil, Gas or Dry Hole) Oil
Date well completed 9/5/25 19
Application for plugging filed 12/7/50 19
Application for plugging approved 19
Plugging commenced 12/8/50 19
Plugging completed 12/11/50 19
Reason for abandonment of well or producing formation Off location for use in
our waterflooding program.
If a producing well is abandoned, date of last production 12/5/50 19
Was permission obtained from the Conservation Division or its agents before plugging was com-
menced? Yes

Name of Conservation Agent who supervised plugging of this well A. R. Daniel
Producing formation Squirrel Sand Depth to top 775' Bottom 793' Total Depth of Well 798'6" Feet
Show depth and thickness of all water, oil and gas formations.

OIL, GAS OR WATER RECORDS

CASING RECORD

Formation	Content	From	To	Size	Put In	Pulled Out
Broken Sand		765'	775'	6 $\frac{1}{2}$ "		707'10"
Oil Sand	Oil	775'	793'	4-7/8"		480'

Describe in detail the manner in which the well was plugged, indicating where the mud fluid was placed and the method or methods used in introducing it into the hole. If cement or other plugs were used, state the character of same and depth placed, from _____ feet to _____ feet for each plug set.

Hole was cemented from 798'6" T.D. to 600' with 40 sacks of cement
Bridge placed at 175'
3 sacks of cement placed on bridge ~
Hole filled to surface with soil and stones.

RECEIVED
STATE CORPORATION COMMISSION
DEC 28 1950
CONSERVATION DIVISION
Wichita, Kansas

No log available on this well

(If additional description is necessary, use BACK of this sheet)

Correspondence regarding this well should be addressed to Deep Rock Oil Corporation
Address Box 127
Osawatomie, Kansas

STATE OF Kansas, COUNTY OF Miami, ss.
T. N. Henderson (employee of owner) or (owner or operator) of the above-described well,
being first duly sworn on oath, says: That I have knowledge of the facts, statements, and matters herein contained and the log of the above-
described well as filed and that the same are true and correct. So help me God.

(Signature) T. N. Henderson
1123 Brown Avenue, Osawatomie, Kansas
(Address)

SUBSCRIBED AND SWORN TO before me this 21 day of December, 1950.

Ada M. Remington
Notary Public.

My commission expires May 1-1952

