


Section 20 Township 21 Range 5EWell No. #1 JeffersCompany Artnell Oil

NORTH

WEST

EAST

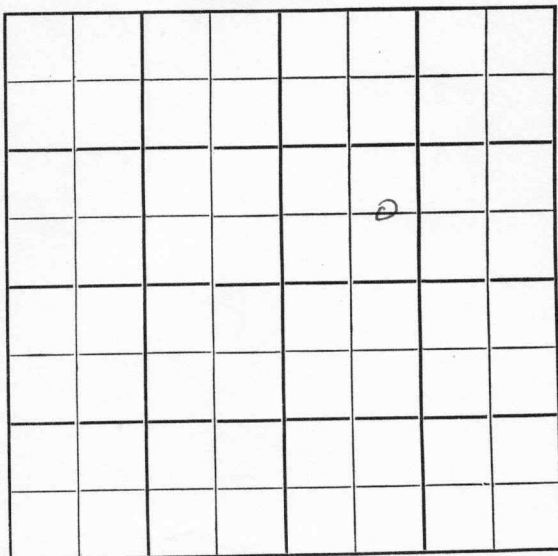

SOUTH

Marion

KANSAS

Sec. 20 Twp. 21 R. 5E

Well No. #1 Jeffers Farm

Artnell Oil Company

Slusser Drlg. - Contr. Contractor

Florence Pool


Ft. from N. Line

660' Ft. from S. Line

Ft. from E. Line

990' Ft. from W. Line

C E L S W N E

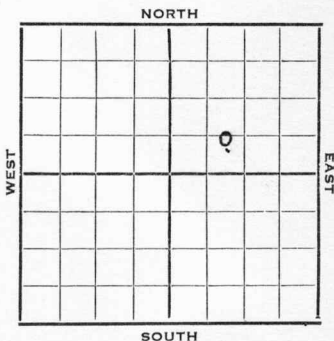

1951 Elev. 1334' REPORT

11/21 Location

1952

2/6 TD 2279 8" @ 2259 POP

2/13 P/9 BF PD

3/12 Oil Well TD 2279

8" @ 112

Doug 1407 Dodge 1522

Lans. 1620 Miss 2123

Kh 2156

5" @ 2259

Misener 2277

TD 2279

FU 500' oil 18 hr. P/15 bopd 10% wtr

P/9 bfpd 25% wtr

Comp. 3 bopd 6 bw

COMPLETED

County Marion State KansasSec. 20 (Blk. Twp.) 21 (Sur. Rge.) 5E Map No.Operator Artnell OilWell No. 1 Farm JeffersElev. Location C E L SW NE (old wells abd)

660 Ft. From S Line NE990 Ft. From W Line Quarter1st. Report NOV 21 1951

Completion

Remarks


Slusser Drlg. - Contr.

Spudding Date

Drlg. Data Florence Pool

Location

County Marion State _____
 Sec. 20 (Blk. 21 (Sur. 5E Map No. _____
 (Twp.) (Rge.)
 Operator Artnell Oil
 Well No. 1 Farm Jeffers (old wells
 Elev. 1334 Location C E L SW NE abd)

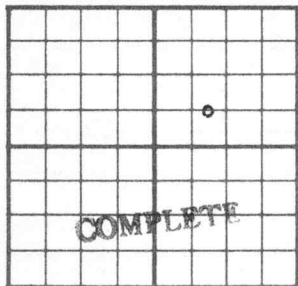

660 Ft. From S Line NE
990 Ft. From W Line Quarter
 1st. Report _____
 Completion MAR 1 2 1952
 Remarks Florence Pool
Slusser Drlg. - Contr.
 Spudding Date _____

Drlg. Data Oil well TD 2279
8" @ 112 Doug. 1407 Dodge 1522
Lans. 1620 Miss. 2123 Kh. 2156
5" @ 2259 Misener 2277 TD 2279
FU 500' oil 18 hr. P/ 15 bopd 10% water
P/ 9 bfpd 25% water
Comp. 3 bopd 6 bw