
FORM 51 Marion KANSAS

Section 20 Township 21 Range 5E

Well No. 1 Jeffres

Company P. L. Edwards Oil et al

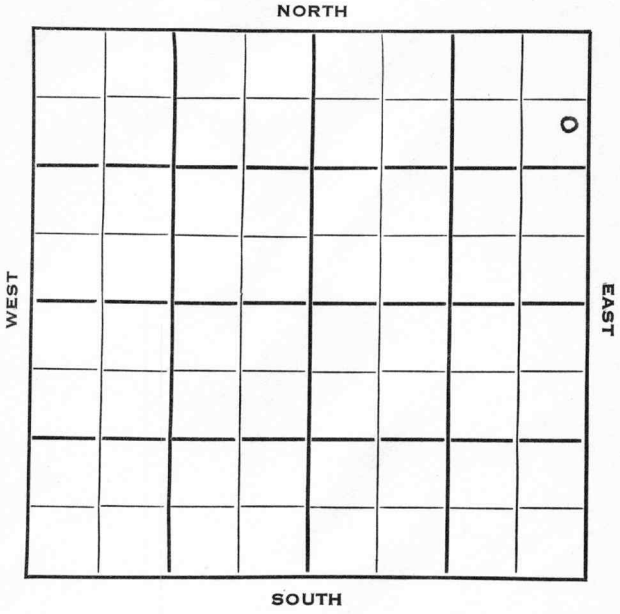

Marion KANSAS

SEC.	TWP.	R.
20	21	5E

WELL NO.

1 Jeffres FARM

COMPANY

P. L. Edwards Oil et al

CONTRACTOR

Berentz

Florence Pool


800 Ft. from N. Line

Ft. from S. Line

200 Ft. from E. Line

Ft. from W. Line

SE NE NE

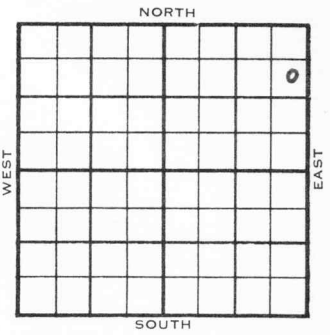

1953	ELEVATION Elev. -	REPORT
9/16	RUR	
10/7	Spud 9-15-53 D & A TD 2296 8" @ 130 Miss 2110 Viola 2282 TD 2282 5" @ 2281 DD 2296 wtr. 500 A wtr. D & A	

ABANDONED

DX-78

FORM 275 FOR SALE BY KANSAS BLUE PRINT CO.


County Marion State Kansas

Sec. 20 (Blk. Twp.) 21 (Sur. Rge.) 5E Map No.

Operator P. L. Edwards Oil etal.

Well No. 1 Farm Jeffres

Elev. Location SE NE NE

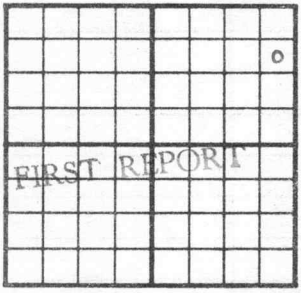

800 Ft. From N Line NE

200 Ft. From E Line Quarter

1st. Report SEP 16 1953

Completion

Remarks

Berentz - Contr.

Spudding Date

Drlg. Data Florence Pool

R U R

J. G. McGEHEE

FORM 275 FOR SALE BY KANSAS BLUE PRINT CO.


County Marion State Kansas

Sec. 20 (Blk. Twp.) 21 (Sur. Rge.) 5E Map No.

Operator P. L. Edwards Oil etal.

Well No. 1 Farm Jeffres

Elev. Location SE NE NE

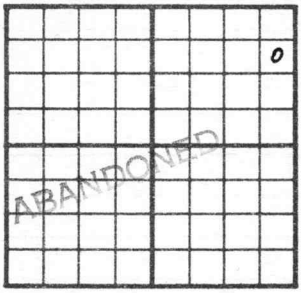

800 Ft. From N Line NE

200 Ft. From E Line Quarter

1st. Report

Completion OCT 7 1953

Remarks Florence Pool

Berentz - Contr.

Spudding Date 9-15-53

Drlg. Data D & A TD 2296

8" @ 130 Miss. 2110 Viola 2282

TD 2282 5" @ 2281 DD 2296 wtr.

500 A wtr.

D & A

J. G. McGEHEE