

Marion

KANSAS


SECTION 20 TOWNSHIP 21S RANGE 5E

WELL NO. #5 Jeffers-Steel

COMPANY Francis Hawn NW NE NE

NORTH

G W/2 NE

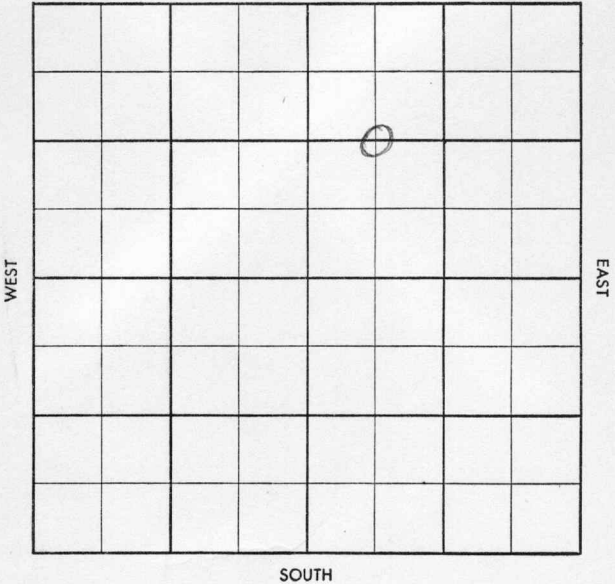

10

County Marion Elev. _____
 Sec. 20 Twp. 21 Rge. 5E
 Company Francis Hawn
 Farm Name Jeffers-Steel No. 5

TOPS	DEPTH	LOG	DATUM
Anh.			
Tp.			
H.			
Tr.			
Dg.			
B.L.			
L.			
K.C.			
B.K.C.			
Ce.			
C.			
M.			
M.			
K.			
Mz.			
Mq.			
V.			
S.			
S.			
A.			
R.			
Pf.			
G.			
T.D.			

Loc. in Sec. App C W/2 NE

SWDW Reg Sd.

Geol. _____

Contr. Target Drlg.

Pool Florence



Date Comm. 1/25/58
8" @ 150, Drlg. 744

Co.

Lse.

No.

Sec.

T.

R.

10

County Marion Elev. 1351 RB 13480
Sec. 20 Twp. 21 Rge. 5E
Company Francis Hawn
Farm Name Jeffers-Steel No. 5

TOPS	DEPTH	LOG	DATUM
Anh.			
Tp.			
H.			
Tr.			
Dg.			
B.L.			
L.			
K.C.			
B.K.C.			
Ce.			
C.			
M.			
M.			
K.	2049		
Mz.			
Mq.			
V.	2299		
S.	2401		
S.			
A.	2483		
R. <i>Red sd</i>	2927		
Pf. <i>C</i>	2974		
G.			
T.D.	2975		

Loc. in Sec. NW NE NE

~~APP C W/2 NE~~

SWDW Reg Sd.

400 PNL
200 FFL

Geol.

Contr.

Target Drlg

Pool

Florence

FEB 26 '58
ABANDON

Date Comm. 1/25/58
8" @ 150, Drlg. 744 559 5 58 PST 2442

- 48 50" 40' MW FP15-30

B1+P860 0 2754 FEB 12 '58 7"

2500 FEB 19 '58 FEB 25 '58 CO 2975 TD

input net 24,000 Bwp d

SWDW