


Section 20 Township 21 Range 4 E

Well No. # 28 Reamey

Company C R A

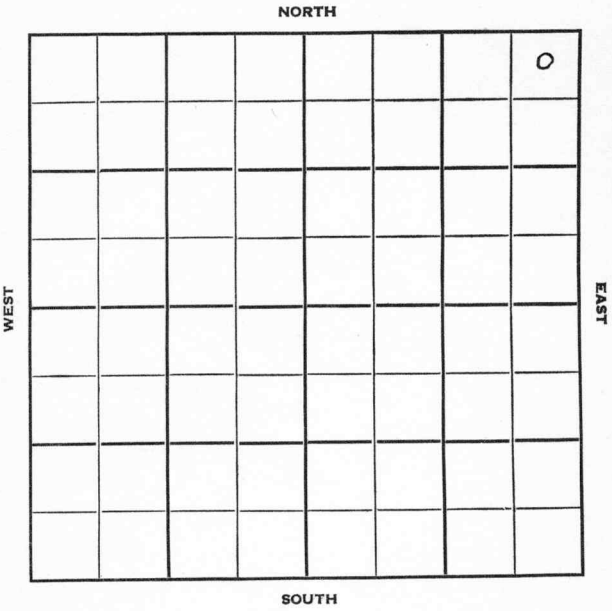

Marion KANSAS

Sec. 20 Twp. 21 R. 4 E

Well No. # 28 Reamey Farm

C R A Company

Uhl Contractor


330 Ft. from N. Line

 Ft. from S. Line

330 Ft. from E. Line

 Ft. from W. Line

NE NE NE

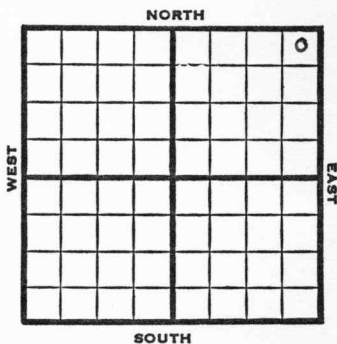

1951

Elev. 1380' REPORT

3/28

Spud 3-27-51
Drilling

4/18

Spud 3-27-51
Oil Well TD 2395
8" @ 114
Misenor 2385 Hunton 2385-89
5" @ 2384
TD 2395
FU 400' oil 2 hr
500 A Comp. 50 bopd

COMPLETED

J. E. TYRA

County Marion State KansasSec. 20 (Blk.) 21 (Sur.) 4E Map No.Operator C R AWell No. 28 Farm ReameyElev. 1380 Location NE NE NE

						0

330 Ft. From N Line NE330 Ft. From E Line Quarter

1st. Report

Completion APR 18 1951

Remarks

Unit - Contr.Spudding Date 3-27-51Drlg. Data Oil well TD 23958" @ 114 Misenor 2385 Hunton 2386-895" @ 2384 TD 2395 FU 400' oil 2 hr.500 A Comp. 50 bopd

J. E. TYRA