


Section 20 Township 21 Range 4E

Well No. #31 Reamey

Company C R A

NORTH

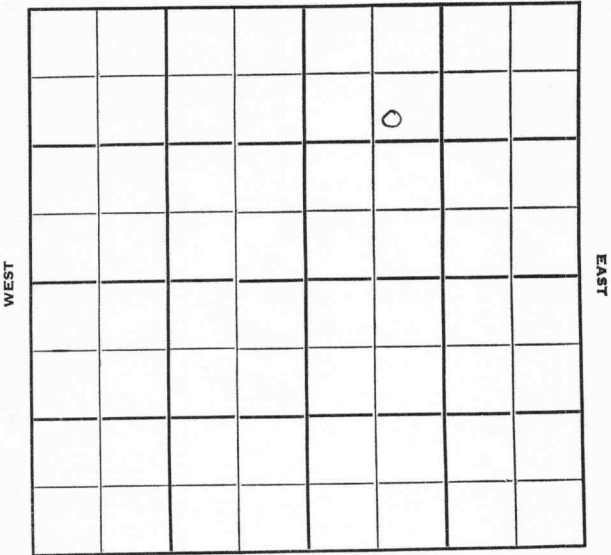

SOUTH

Marion

KANSAS

Sec. 20 Twp. 21 R. 4E

Well No. #31 Reamey Farm

C R A Company

Uhl Drlg. Contractor


1100 Ft. from N. Line

\_\_\_\_\_ Ft. from S. Line

\_\_\_\_\_ Ft. from E. Line

840 Ft. from W. Line

SE NW NE

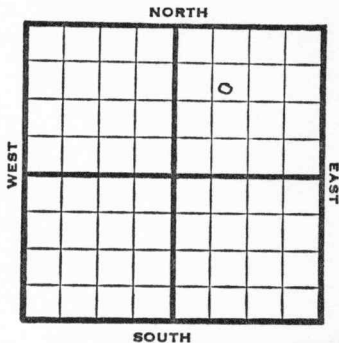

1951 Elev. 1366' REPORT

12/5 8" @ 91  
 Lans. 1743 KC 1979  
 Kh. 2258 Hunton 2366-71  
 5" @ 2367 WOC

1952  
 1/9 Oil Well TD 2392  
 8" @ 91  
 Lans. 1743 KC 1979  
 Kh 2258 Hunton 2366-71  
 5" @ 2367' Viola 2387  
 TD 2392  
 7 goph 500 A Comp. 130 bopd

**COMPLETED**



