

KANSAS


Marion

Form 51-5M-4-86-Palace

Section 20 Township 21 Range 4-E

Well Number #18 Remey (Reamey)

Company National Refg.

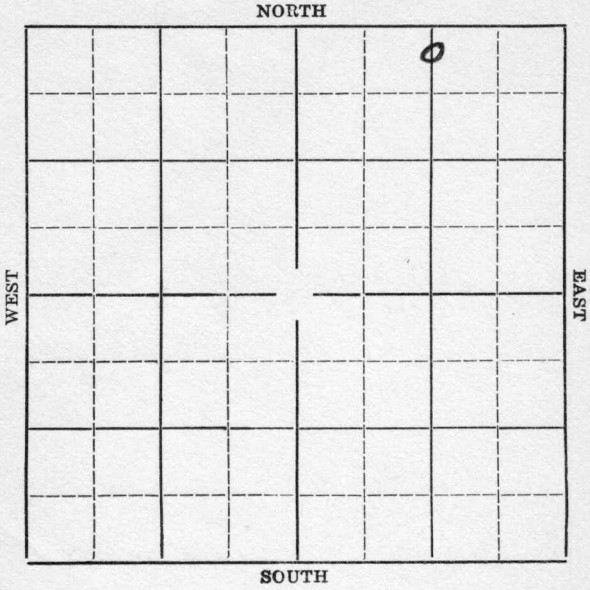



**KANSAS**


Map No. 23 Sec. 20 Twp. 21 R. 4E

Well No. 18 Remy

National Ref. Company

Contractor

**SECTION PLAT**

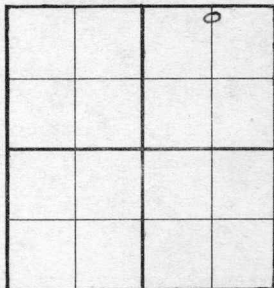

300 Ft. from N. Line

\_\_\_\_\_ Ft. from S. Line

1320 Ft. from E. Line

\_\_\_\_\_ Ft. from W. Line

**FIRST REPORT**

Location \_\_\_\_\_

Rig up \_\_\_\_\_

Drilling and Remarks:

*Mach.*

**RECORD**

Cased \_\_\_\_\_ in., \_\_\_\_\_ ft.

Sand \_\_\_\_\_

Gas \_\_\_\_\_

Oil \_\_\_\_\_

Total Depth \_\_\_\_\_

**PRODUCTION**

1st 24 hrs. Nat. \_\_\_\_\_

1st 24 hrs. after shot \_\_\_\_\_

Gas \_\_\_\_\_ Cu. Ft.

Dry Hole \_\_\_\_\_

Abandoned \_\_\_\_\_

Date

NOV 4 1936 19

S. J. LEWIS

Scout

Map No. 23 Sec. 20 Twp. 21 R. 4E

Well No. 18 Remy

National Key Company

Contractor

SECTION PLAT

		0

300 Ft. from N. Line

\_\_\_\_\_ Ft. from S. Line

1320 Ft. from E. Line

\_\_\_\_\_ Ft. from W. Line

COMPLETED

Location \_\_\_\_\_

Rig up \_\_\_\_\_

Drilling and Remarks:

*Kansas City 1755  
1000 cu ft  
P 8 168*

RECORD

Cased \_\_\_\_\_ in., \_\_\_\_\_ ft.

Sand \_\_\_\_\_

Gas \_\_\_\_\_

Oil \_\_\_\_\_

Total Depth 2068

PRODUCTION

1st 24 hrs. Nat. \_\_\_\_\_

1st 24 hrs. after shot \_\_\_\_\_

Gas \_\_\_\_\_ Cu. Ft.

Dry Hole \_\_\_\_\_

Abandoned \_\_\_\_\_

Date

DEC 9 1936 19

S. J. LEWIS Scout