

KANSAS


FORM 51 5M 4-41 PETROL

Marion

Section 20 Township 21 Range 4E

Well No. 21 Reamey

Company National Refining

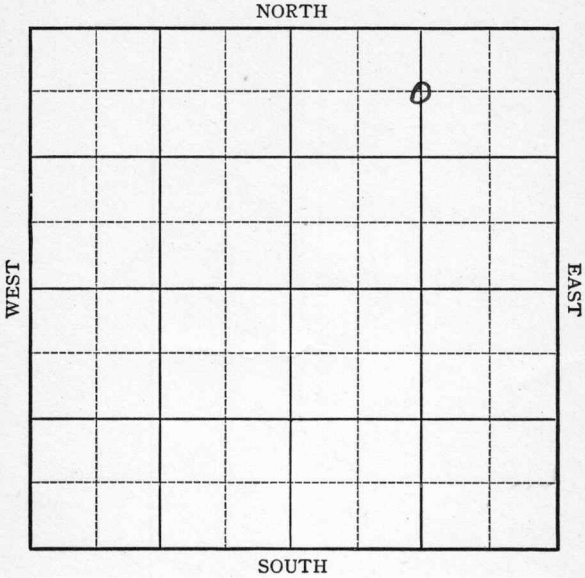

Map No. 23 Sec. 20 Twp. 21 R. 4E

Well No. 21 Reamey

National Refining Company

Contractor

FIRST REPORT

C $N\frac{1}{2}$ NE

660 Ft. from N. Line

_____ Ft. from S. Line

1320 Ft. from E. Line

_____ Ft. from W. Line

PEABODY POOL

SECTION PLAT

			○

Location _____

Rig up _____

Drilling and Remarks:
Cellar

RECORD

Cased _____ in., _____ ft.

Sand _____

Gas _____

Oil _____

Total Depth _____

PRODUCTION

1st 24 hrs. Nat. _____

1st 24 hrs. after shot _____

Gas _____ Cu. Ft.

Dry Hole _____

Abandoned _____

Date

JUN 4 1941
19

S. J. LEWIS Scout

Map No. 23 Sec. 20 Twp. 21 R. 4E

Well No. 21 Reamey

National Refining Company

COMPLETED Contractor

C N $\frac{1}{2}$ NE

660 Ft. from N. Line


_____ Ft. from S. Line

1320 Ft. from E. Line

_____ Ft. from W. Line

PEABODY POOL

SECTION PLAT

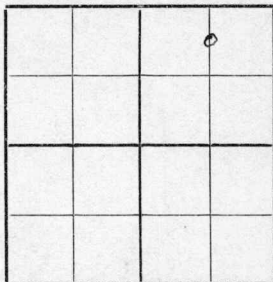

Location _____

Rig up _____

Drilling and Remarks:

KC 1985
5" @ 1987
5000 acft
Pump 45 oil
15 water

34 2 Gr

RECORD

Cased _____ in., _____ ft.

Sand _____

Gas _____

Oil _____

Total Depth 2064

PRODUCTION

1st 24 hrs. Nat. _____

1st 24 hrs. after shot _____

Gas _____ Cu. Ft.

Dry Hole _____

Abandoned _____

Date

JUL 9 1941 19

S. J. LEWIS

Scout