


Section 20 Township 21 Range 14EWell No. #30 ReameyCompany Cooperative Refinery Ass'n.

NORTH

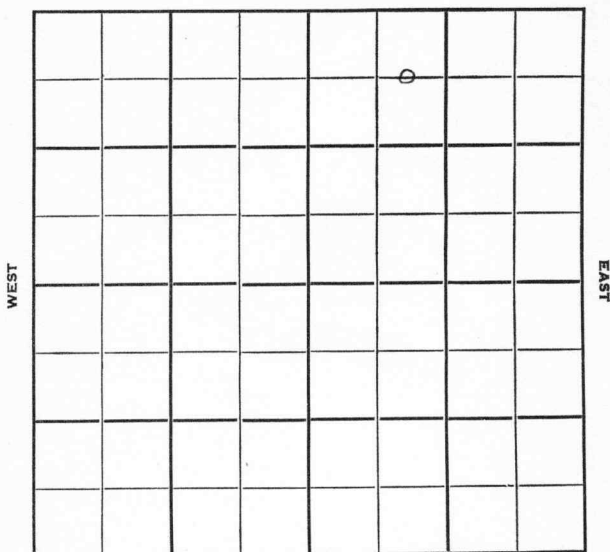

SOUTH

Marion

KANSAS

Sec. 20 Twp. 21 R. 4E

Well No. #30 Reamey Farm

Cooperative Ref. Ass'n. Company

Uhl Drlg. Contractor


660' Ft. from N. Line

_____ Ft. from S. Line

_____ Ft. from E. Line

990' Ft. from W. Line

C E/2 NW NE

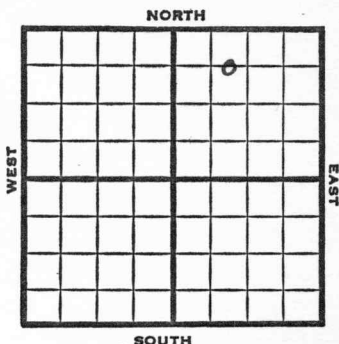

1951

Elev. 1376' REPORT

9/19

Location

10/17

Spud -

Oil Well TD 2400'

8" @ 118'

Lans. 1753 KC 1991

Chatanoogaash. 2365

Hunton 2380-81


5" @ 2380

Viola 2398

TD 2400' FU 450' oil 15 min.

Comp. 100 BOPD

COMPLETED

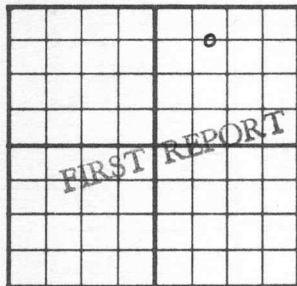County **Marion** State **Kansas**Sec. **20** (Blk. Twp.) **21** (Sur. Rge.) **4E** Map No.Operator **Cooperative Refinery Ass'n**Well No. **30** Farm **Reamey**Elev. Location **CE/2 NW NE****660** Ft. From **N** Line **NE****990** Ft. From **W** Line Quarter1st. Report **SEP 19 1951**

Completion


Remarks

Spudding Date

Drlg. Data

Location**J. E. TYRA**

County Marion State Kansas
 Sec. 20 (Blk. 21) (Sur. 4E) Map No. _____
 Operator Cooperative Refinery Assn.
 Well No. 30 Farm Reamey
 Elev. 1376 Location C E L NW NE

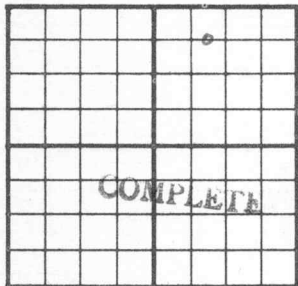

660 Ft. From N Line NE
990 Ft. From W Line Quarter
 Ist. Report _____
 Completion OCT 17 1951
 Remarks _____
Uhl Drlg. - Contr.
 Spudding Date _____

Drlg. Data Oil well TD 2400
8" @ 118 Lans. 1753 KC 1991
Chatanooga shale 2365 Hunton 2380-81
5" @ 2380 Viola 2398 TD 2400
FU 450' oil 15 min. Comp. 100 bopd

J. E. TYRA