


Marion KANSAS

DX 78-1

Section 20 Township 21 Range 5E
Well No. 2 Jeffers
Company P. L. Edwards et al

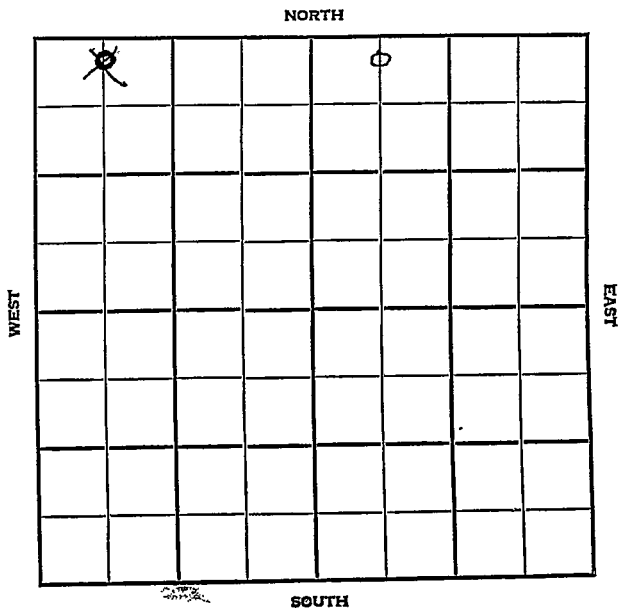

Marion KANSAS

SEC.	TWP.	R.
20	21	5E

WELL NO.

2 Jeffers

FARM

COMPANY

P. L. Edwards et al

CONTRACTOR

Ola Berentz

Florence Pool


100 Ft. from N. Line

Ft. from S. Line

Ft. from E. Line

~~600~~
~~690~~ Ft. from W. Line

C N/2 NW ~~NW~~ ^{NE}

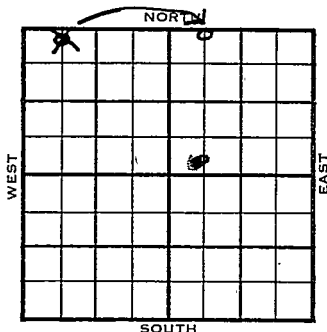

	ELEVATION	REPORT
1954	1304'	
8/4	Viola 2244'	
	TD 2245'	
	4" @ 2244'	
	CO to 2246	
	FU 150' oil 550' wtr. 12 hrs.	
	B/1 bo 6 bw 12 hrs., tstg.	
10/27	Oil Well	
	TD 2245'	
	Viola 2244'	
	TD 2245'	
	4" @ 2244'	
	CO to 2246'	
	FU 150' oil 550' wtr. 12 hr.	
	B/ 1 bo 6 bw 12 hr. 500 A S/ 4 boph	
	P/ 5 boph 60 bw. 2½ hr.	
	Comp 25 bopd.	

COMPLETED



J. G. McGEHEE

Map No. _____ Sec. 20 Twp. 21 R. 5EWell No. 2 Jeffers

P. L. Edwards et al.

Company

CORRECTION

Contractor

C $N\frac{1}{2}$ NW NE

SECTION PLAT

100 Ft. from N. Line Ft. from S. Line Ft. from E. Line600 Ft. from W. Line

		o	

Marion County

Location _____

Rig up _____

Drilling and Remarks:

Reported

C $N\frac{1}{2}$ NW NW

RECORD

Cased _____ in., _____ ft.

Sand _____

Gas _____

Oil _____

Total Depth _____

PRODUCTION

1st 24 hrs. Nat. _____

1st 24 hrs. after shot _____

Gas _____ Cu. Ft.

Dry Hole _____


Abandoned _____

Date

AUG 18 1954

19

FABEN GILSTRAP Scout

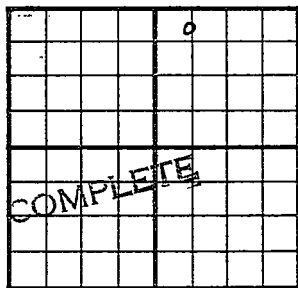County Marion State KansasSec. 20 (Blk.
Twp.) 21 (Sur.
Rge.) 5E Map No.Operator P. L. Edwards et al.Well No. 2 Farm JeffersElev. 1304 Location C N $\frac{1}{2}$ NW NE100 Ft. From N Line NE690 Ft. From W Line QuarterIst. ReportCompletion OCT 27 1954Remarks Florence PoolOla Berentz - Contr.Spudding DateDrilg. Data Oil well TD 2245Viola 2244 TD 2245 4" @ 2244 CO to2246 FU 150' oil 550' wtr. 12 hr.B/ 1 bo 6 bw 12 hr. 500 A S/ 4 bophP/ 5 boph 60 bw 2 $\frac{1}{2}$ hr.Comp. 25 bopd

FABEN-G'LTR