


Marron
KANSAS

Section 20 Township 21 Range 4E

Well Number 19 Reamey *(Reamey)*

Company National Ref.

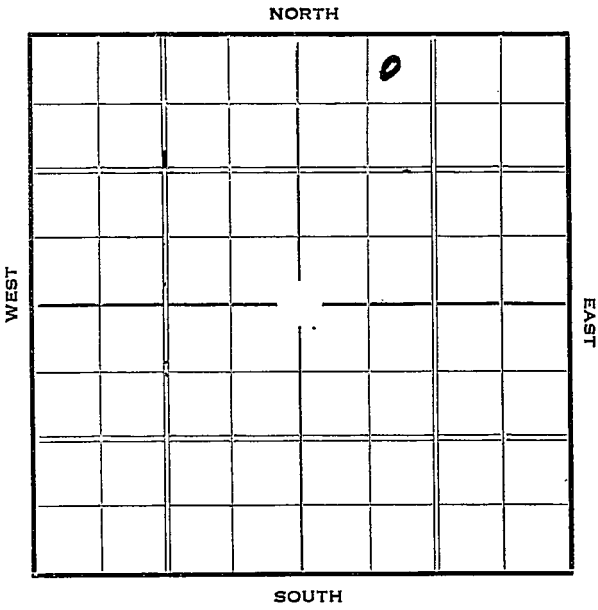

KANSAS

Marion

Map No. Sec. 20 Twp. 21 R. 4E

Well No. 19 Ramey Farm


..... National Ref. Company

330 Ft. from N. Line

..... Ft. from S. Line

..... Ft. from E. Line

810 Ft. from W. Line

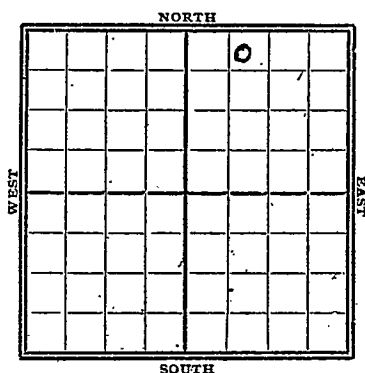Date
1936

REPORT

12-9 Location

12/17 "

12/24 12" @ 1040'. Drlg. 1060'.

12/29 10" @ 1463'. Drlg. 1770'.

1937

1/7 Drlg. 1770'.

1/14 K. C. L. 1740'. Show oil 1980

Pay 2054-61' T. D. Pot 57 bbls

1/20 K. C. L. 1740'. Pay 2054-61'

T. D. 2061'. 1520 acid.

Pot. 325 bbls.

COMPLETED

KANSAS

Map No. 23 Sec. 20 Twp. 21 R. 4EWell No. 19 RemeyNational Ry. Company

Contractor

SECTION PLAT

		0	

330 Ft. from N. Line

_____ Ft. from S. Line

_____ Ft. from E. Line

810 Ft. from W. Line

FIRST REPORT

Location ✓

Rig up _____

Drilling and Remarks:

RECORD

Cased _____ in., _____ ft.

Sand _____

Gas _____

Oil _____

Total Depth _____

PRODUCTION

1st 24 hrs. Nat. _____

1st 24 hrs. after shot _____

Gas _____ Cu. Ft.

Dry Hole _____

Abandoned _____

Date

DEC 9 1936 19

S. J. LEWIS Scout

Map No. 23 Sec. 20 Twp. 21 R. 4EWell No. 19 B. K. RemeyNational R. J. Company

Contractor

SECTION PLAT

		0	

330 Ft. from N. Line

_____ Ft. from S. Line

_____ Ft. from E. Line

810 Ft. from W. Line

COMPLETED

Location _____

Rig up _____

Drilling and Remarks:

KO 4 1740Pay 2054-61520 acidPo 8325 8 1/2

RECORD

Cased _____ in., _____ ft.

Sand _____

Gas _____

Oil _____

Total Depth 2061

PRODUCTION

1st 24 hrs. Nat. _____

1st 24 hrs. after shot _____

Gas _____ Cu. Ft.

Dry Hole _____

Abandoned _____

Date

JAN 20 1937S. J. LEWIS Scout