

Handwritten mark

STATE CORPORATION COMMISSION OF KANSAS  
OIL & GAS CONSERVATION DIVISION  
WELL COMPLETION OR RECOMPLETION FORM  
ACO-1 WELL HISTORY  
DESCRIPTION OF WELL AND LEASE

003-22,914

API NO. 15-.....  
County..... Anderson  
SW.. SE.. S.E. Sec. 5. Twp. 21. Rge. 21. X East  
West

Operator: License # 4693  
Name The Xenia Corporation  
Address Route 1, Box 286  
City/State/Zip Garnett, Ks 66032

990 Ft North from Southeast Corner of Section  
1485 Ft West from Southeast Corner of Section  
(Note: Locate well in section plat below)

Purchaser Enron

Lease Name Kittle Well # 3

Operator Contact Person H. H. Lemon  
Phone 913/898-6218

Field Name Bush City Shoe String


Producing Formation Squirrel

Elevation: Ground NA KB NA

Fracture License # 3784  
Name Kansas Drillers Inc

Wellsite Geologist None  
Phone

Section Plat

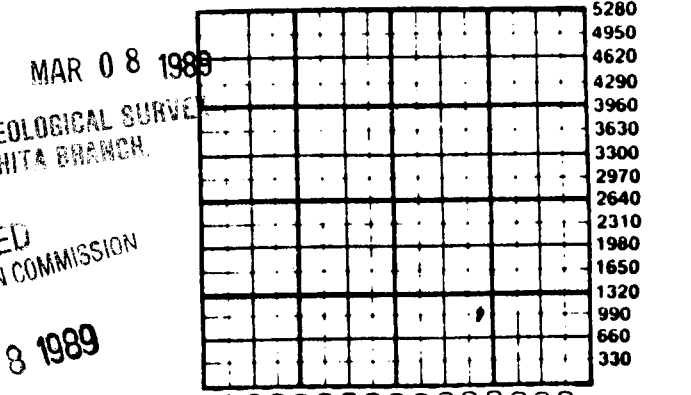

Designate Type of Completion  
X New Well Re-Entry Workover  
X Oil Gas SWD Inj X Temp Abd Delayed Comp.  
Dry Other (Core, Water Supply etc.)

If OWO: old well info as follows:  
Operator  
Well Name  
Comp. Date Old Total Depth

WATER SUPPLY INFORMATION  
Disposition of Produced Water: Disposal  
Docket # Repressuring

WELL HISTORY

Drilling Method:  
X Mud Rotary Air Rotary Cable  
9/6/88 TA  
Start Date Date Reached TD Completion Date

Questions on this portion of the ACO-1 call:  
Water Resources Board (913) 296-3717  
Source of Water:  
Division of Water Resources Permit #

Total Depth PBD

Groundwater.....Ft North from Southeast Corner  
(Well) .....Ft West from Southeast Corner of  
Sec Twp Rge East West

Amount of Surface Pipe Set and Cemented at 20 feet  
Multiple Stage Cementing Collar Used? Yes X No  
If yes, show depth set.....feet  
If alternate 2 completion, cement circulated  
from.....feet depth to.....w/.....SX cmt  
Cement Company Name  
Invoice #

Surface Water.....Ft North from Southeast Corner  
(Stream, pond etc).....Ft West from Southeast Corner  
Sec Twp Rge East West

Other (explain).....  
(purchased from city, R.W.D. #)

INSTRUCTIONS: This form shall be completed in duplicate and filed with the Kansas Corporation Commission, 200 Colorado Derby Building, Wichita, Kansas 67202, within 90 days after completion or recompletion of any well. Rule 82-3-130 and 82-3-107 apply.  
Information on side two of this form will be held confidential for a period of 12 months if requested in writing and submitted with the form. See rule 82-3-107 for confidentiality in excess of 12 months.  
One copy of all wireline logs and drillers time log shall be attached with this form. Submit CP-4 form with all plugged wells. Submit CP-111 form with all temporarily abandoned wells.

**SIDE TWO**

Operator Name The Xenia Corporation Lease Name Kittle Well # 3

Sec. 5 Twp. 21 Rge. 21  East  West County Anderson

**WELL LOG**

**INSTRUCTIONS: Show important tops and base of formations penetrated. Detail all cores. Report all drill stem tests giving interval tested, time tool open and closed, flowing and shut-in pressures, whether shut-in pressure reached static level, hydrostatic pressures, bottom hole temperature, fluid recovery, and flow rates if gas to surface during test. Attach extra sheet if more space is needed. Attach copy of log.**

Drill Stem Tests Taken  Yes  No  
 Samples Sent to Geological Survey  Yes  No  
 Cores Taken  Yes  No

**Formation Description**  
 Log  Sample

Name Top Bottom

Spuded 9/6/88-Rig broke down. Well will be completed when the price of oil makes it feasible to do so.

<b>CASING RECORD</b> <input type="checkbox"/> New <input checked="" type="checkbox"/> Used Report all strings set-conductor, surface, intermediate, production, etc.							
Purpose of String	Size Hole Drilled	Size Casing Set (In O.D.)	Weight Lbs/Ft.	Setting Depth	Type of Cement	#Sacks Used	Type and Percent Additives
Surface	8 3/4"	7"	20 <sup>1/2</sup>	20'	Prt Ind	5	None
<b>PERFORATION RECORD</b> Shots Per Foot   Specify Footage of Each Interval Perforated				<b>Acid, Fracture, Shot, Cement Squeeze Record</b> (Amount and Kind of Material Used)   Depth			
<b>TUBING RECORD</b>				Size	Set At	Packer at	Liner Run <input type="checkbox"/> Yes <input type="checkbox"/> No
Date of First Production		Producing Method					
		<input type="checkbox"/> Flowing <input type="checkbox"/> Pumping <input type="checkbox"/> Gas Lift <input type="checkbox"/> Other (explain).....					