


Kansas ✓

Map No. _____ Sec. 21 Twp. 21 R. 9Well No. 1 Nation Farm _____Springstead Etal Company _____

NORTH

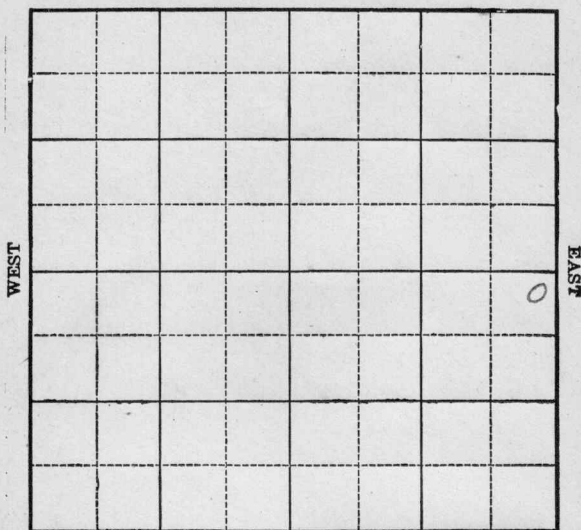

SOUTH

Location _____

Rig up _____

Drilling Remarks:

Drilling Remarks:

RECORD

Cased _____ in. _____ ft.

Sand _____

Gas _____

Oil _____

Total Depth _____

PRODUCTION

1st 24 hrs Nat. _____

1st 24 hrs. after shot _____

Gas _____ cu. ft.

Dry Hole _____

Abandoned _____

Map No. _____ Sec. 21 Twp. 21 R. 9

Well No. 1 Nation Farm
Springstead Eval Company

NORTH


200 Ft. from N. Line

_____ Ft. from S. Line

200 Ft. from E. Line

_____ Ft. from W. Line

WEST

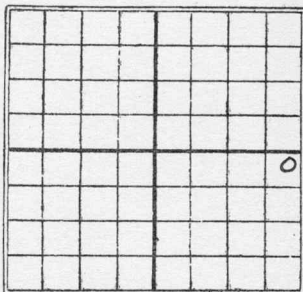

EAST

SOUTH

Date

REPORT

1922

12/30

D & G - 2600'

Map No. *K22* Sec. *21* Twp. *21* R. *9*Well No. *1* *Nation**Springstead et al.* Company

Contractor

SECTION PLAT

200' Ft. from N. Line

Ft. from S. Line

200' Ft. from E. Line

Ft. from W. Line

FIRST REPORT
ABANDONED

Location

Rig up

Drilling and Remarks:

*Top Miss 2585'**10 + 0 2600'*

RECORD

Cased _____ in., _____ ft.

Sand _____

Gas _____

Oil _____

Total Depth _____

PRODUCTION

1st 24 hrs. Nat. _____

1st 24 hrs. after shot _____

Gas _____ Cu. Ft.

Dry Hole _____

Abandoned _____

Date

12/30/22 191*MAB*

Scout