


KANSAS Marion

Section 21 Township 21 Range 4EWell No. 2 Robinson "B"Company C R A

Sellers Pool

NORTH

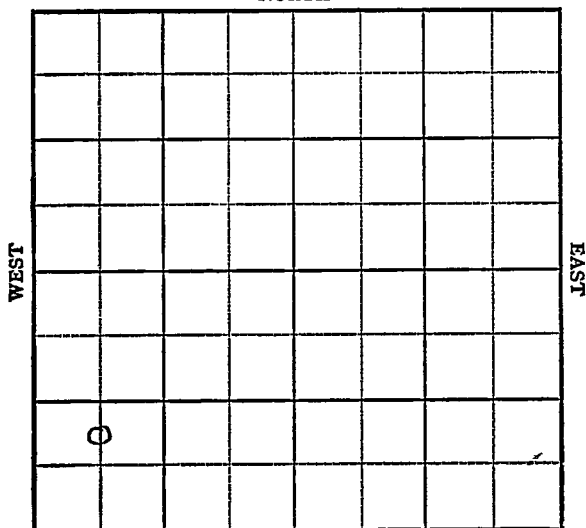

SOUTH

KANSAS

Marion

Sec. 21 Twp. 21 R. 4E

Well No. #2 Robinson "B" Farm

C R A

Company

Sellers Pool


 Ft. from N. Line

990' Ft. from S. Line

 Ft. from E. Line

660' Ft. from W. Line

C N L SW SW

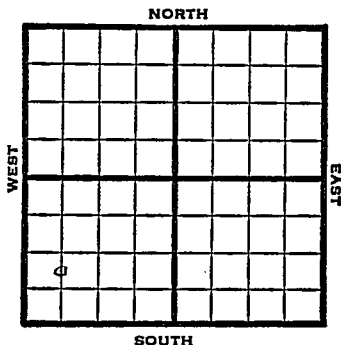

1948

Eli 1327'

R E P O R T

12/8

8" @ 70'

12/14

Drlg. 2020'

12/22

Chat 2198'

Viola 2373'

5" @ 2373'

TD 2376'

500' oil - 8 hrs.

TD 2376'

Viola 2373'

5"@ 2373'

Pump 58 oil Pot

38° Gr.

Comp

COMPLETED

Map No. _____ Sec. 21 Twp. 21 R. 4EWell No. 2 Robinson "B"C R A _____ CompanyFIRST REPORT _____ Contractor


C N L SW SW

SECTION PLAT

_____ Ft. from N. Line

990 _____ Ft. from S. Line

_____ Ft. from E. Line

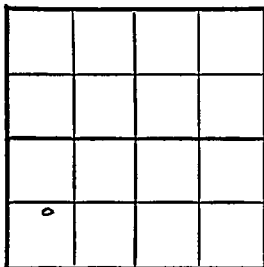660 _____ Ft. from W. Line

Marion County

Location _____

Rig up _____

Drilling and Remarks:

8" @ 70

RECORD

Cased _____ in., _____ ft.

Sand _____

Gas _____

Oil _____

Total Depth _____

PRODUCTION

1st 24 hrs. Nat. _____

1st 24 hrs. after shot _____

Gas _____ Cu. Ft.

Dry Hole _____

Abandoned _____

Date

DEC 8 1948 19 _____ S. J. LEWIS Scout

Map No. 22 Sec. 21 Twp. 21 R. 4E

Well No. 2 Robinson "B"

C R A Company

COMPLETE Contractor

C N L SW SW

E. 1827

SECTION PLAT

 Ft. from N. Line

990 Ft. from S. Line

 Ft. from E. Line

660 Ft. from W. Line

o			

Marion County

Location

Rig up

Drilling and Remarks:

Vis 1w 2823

5" @ 2823

Any 5000 Rod

3500

RECORD

Cased in., ft.

Sand

Gas

Oil

Total Depth 2376

PRODUCTION

1st 24 hrs. Nat.

1st 24 hrs. after shot

Gas Cu. Ft.

Dry Hole

Abandoned

Date

DEC 29 1948

19

S. J. LEWIS

Scout